

Amite
A 202
7/14/80

MISSISSIPPI
BOARD OF WATER COMMISSIONERS
416 North State Street
Jackson, Mississippi 39201

WATER WELL DRILLERS LOG

date well completed 1980 Amite Well Co firm name Amite county well located


LANDOWNER:
McCarl Butler
Rt. Coler
(mailing address)

WELL LOCATION:
sec. 29 T 4 N R 2 E
1 1/2 miles east of Coler
(distance) (direction) (nearest town)

WELL PURPOSE: home
(home, irrigation, municipal, industrial)

- WELL COMPLETION DATA:
- (1) diameter (inches) 4"
 - (2) total depth (feet) 80
 - (3) static water level (feet) 20 below top of ground.
 - (4) casing plastic bottom
(material) (depth)
 - (size) 7 if telescope see back.
 - (5) screen 5' 75'
(length) (depth to top)
 - (size) 4" (material) plastic
 - (6) pump 1/2 10
(HP) (yield gpm)
 - (type power) elec
 - (7) electric log no
(yes or no)
 - (organization running log)

description of formations encountered	from	to
<u>Clay</u>	<u>0</u>	<u>5</u>
<u>White sand</u>	<u>5</u>	<u>20</u>
<u>sand & gravel</u>	<u>20</u>	<u>28</u>
<u>fine white sand</u>	<u>28</u>	<u>60</u>
<u>sand & pea gravel</u>	<u>60</u>	<u>80</u>

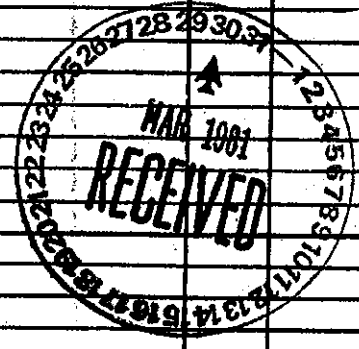

(8) how well bottom plugged
check back

DRILLERS REMARKS: