

AMITE MISSISSIPPI BOARD OF WATER COMMISSIONERS

B7

8-21-64 WATER WELL DRILLERS LOG

Date: 8-21, 1964, Driller: Chester Reeves County Amite-  
(Name)

(1) Owner of Land	Description & Color of Materials Sand, Clay, Red Clay, Shell, etc.	Thick- ness Feet	Depth Feet
Leffertudge RFD Master (Name) (Address)	Red Clay	25	25
	Red Sand	15	40
(2) Location: 1/4, 1/4, Sec 33 T4 R3, 4 to 10 miles N1/2 E, of Master (distance) (direction) (Nearest Town)	Small gravel	40	80
	gravel	5	85
(3) Topography: Hilly (Hilly) (Flat) (level)	Red Clay	8	93
(4) Purpose of Well: Domestic (Domestic Irrigation Municipal, Industrial, Other)	Red gravel sand	25	118

Information upon completion of well:


- (1) Diameter 4 inches.
- (2) Total Depth 118 feet.
- (3) Water Level 70 feet below top of ground.
- (4) Cased to bottom size
- (5) Screen: Size 4, Length 7'
- (6) Were any formations sealed against pollution?  
yes,  no.

If YES depth of formation \_\_\_\_\_

Why \_\_\_\_\_

Drillers Remarks:

old well Bad

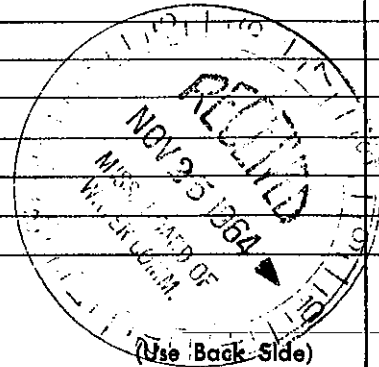

Well No.

Mail this copy to Board of Water Commissioners 429 Miss. St. Jackson, Miss.