

AMITE MISSISSIPPI BOARD OF WATER COMMISSIONERS

B8

10-23-64 WATER WELL DRILLERS LOG

INDEXED

Date: 10-23, 1964, Driller: Chester Reeves County Amite
(Name)

	Description & Color of Materials Sand, Clay, Red Clay, Shell, etc.	Thick- ness Feet	Depth Feet
(1) Owner of land: <u>Mrs. Martin</u> <u>W. D. Martin</u> <u>4 FD - Slaster</u> (Address)	Red clay	2.5	2.5
(2) Location: <u>33 4 3</u> <u>8 to 10</u> miles <u>N. E.</u> of <u>Slaster</u> (distance) (direction) (Nearest Town)	Red sand	15	40
(3) Topography: <u>Hilly</u> (Hilly) (Flat) (Level)	Small gravel	35	75
(4) Purpose of Well: <u>Domestic</u> (Domestic Irrigation Municipal, Industrial, Other)	Red clay	5	80
	Red gravel sand	31	111


Information upon completion of well:

- (1) Diameter 4 inches.
- (2) Total Depth 111 feet.
- (3) Water Level 73 feet below top of ground.
- (4) Cased to Bottom Size 4'
- (5) Screen: Size 4', Length 7'
- (6) Were any formations sealed against pollution?
_____ yes, no.

If YES depth of formation _____

Why _____

Drillers Remarks: red well
insufficient

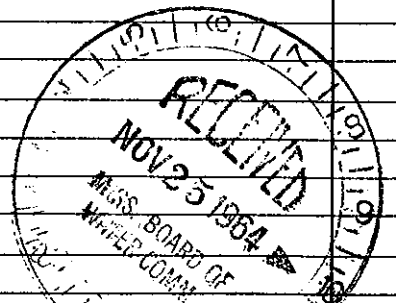

REEVES WELL & PUMP CO.
P. O. BOX 71 PHONE 684-1461
McCOMB, MISS.

(Use Back Side)

Well No.

Mail this copy to Board of Water Commissioners 429 Miss. St. Jackson, Miss.