

AMITE MISSISSIPPI BOARD OF WATER COMMISSIONERS

B9

10-27-64 WATER WELL DRILLERS LOG

Date: 10-27, 1964, Driller: Chester Reeves County Amite

		Description & Color of Materials Sand, Clay, Red Clay, Shell, etc.	Thick- ness Feet	Depth Feet
(1) Owner of Land: Mrs. Winnie W. Wittington RFD - Glaston (Address)		Clay	15	15
		Red Sand	55	70
(2) Location: 1/4, 1/4, Sec. 33 4 R 3, 4.10 miles N.E. of Glaston (distance) (direction) (Nearest Town)		Red gravel & Sand	12	82
		white chalk	18	100
(3) Topography: Hilly (Hilly) (Flat) (Level)		Chalky sand	20	120
(4) Purpose of Well: Domestic (Domestic Irrigation, Municipal, Industrial, Other)		Coarse sand & Red gravel	16	136


Information upon completion of well:

- (1) Diameter 4 inches.
- (2) Total Depth 136 feet.
- (3) Water Level 80 feet below top of ground.
- (4) Cased to bottom size.
- (5) Screen: Size 4, Length 7'
- (6) Were any formations sealed against pollution?
yes, no.

If YES depth of formation

Why

Drillers Remarks: old well
not adequate

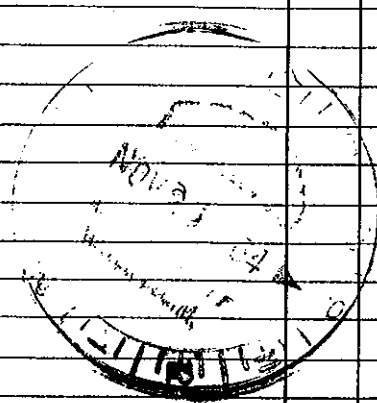

REEVES WELL & PUMP CO.
P. O. BOX 71 - PHONE 694-1451
McCOMB, MISS.
(Use Back Side)

Well No.

Mail this copy to Board of Water Commissioners 429 Miss. St. Jackson, Miss.