

AMITE
B10

MISSISSIPPI BOARD OF WATER COMMISSIONERS

5-21-65 WATER WELL DRILLERS LOG

Date: 5-21, 1965, Driller: Chester Keener County: Amite


(1) Owner of Land: Mrs Lennie Williams Rt. 4, Gloster (Name) (Address)	Description & Color of Materials Sand, Clay, Red Clay, Shell, etc.	Thick- ness Feet	Depth Feet
	Red Clay	30	30
	Sample	15	45
	Red Clay	15	60
	Red sandy		
	Sand	22	82
	white sand		
	white chalk	28	210
	white sand	16	226

(2) Location: 1/4, 1/4, Sec 24 T4 R3,
0 miles N.W. Liberty,
(distance) (direction) (Nearest Town)
(3) Topography: Hilly
(Hilly) (Flat) (Level)
(4) Purpose of Well: Domestic
(Domestic Irrigation
Municipal, Industrial, Other)

Information upon completion of well:

(1) Diameter 4 inches.
(2) Total Depth 226 feet.
(3) Water Level 111 feet below top of ground.
(4) Cased to Bottom Size
(5) Screen: Size 4, Length 7'
(6) Were any formations sealed against pollution?
yes, no. no.

If YES depth of formation
Why
Drillers Remarks: old well
had -

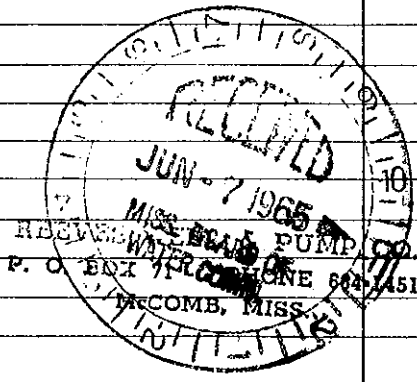

Well No.

(Use Back Side)

Mail this copy to Board of Water Commissioners 429 Miss. St. Jackson, Miss.