

AMITE
B 11

MISSISSIPPI BOARD OF WATER COMMISSIONERS

12-6-65 WATER WELL DRILLERS LOG

Date: 12-6, 1965, Driller: F. T. Covington County Richmond
(Name)

(1) Owner of Land:	Description & Color of Materials Sand, Clay, Red Clay, Shell, etc.	Thick- ness Feet	Depth Feet
<u>Pagel Arnold</u> (Name)	<u>Sandy Clay</u>	<u>20</u>	<u>20</u>
<u>Gloster, Miss</u> (Address)	<u>Sand & Rock</u>	<u>15</u>	<u>35</u>
(2) Location: $\frac{1}{4}$, $\frac{1}{4}$, Sec. <u>34</u> <u>W</u> <u>3</u> rd	<u>Clay</u>	<u>20</u>	<u>55</u>
<u>2</u> miles <u>West</u> of <u>Bay Cove</u>	<u>Sand</u>	<u>9</u>	<u>64</u>
(distance) (direction) (Nearest Town)			
(3) Topography: <u>Hilly</u>			
(Hilly) (Flat) (Level)			
(4) Purpose of Well:			
(Domestic Irrigation Municipal, Industrial, Other)			

Information upon completion of well:


- (1) Diameter 4" inches.
- (2) Total Depth 64' feet.
- (3) Water Level 35' feet below top of ground.
- (4) Cased to 64', Size 4"
- (5) Screen: Size 4", Length 6'
- (6) Were any formations sealed against pollution?
_____ yes, no.

If YES depth of formation _____

Why _____

Drillers Remarks: _____

Mail this copy to Board of Water Commissioners 429 Miss. St. Jackson, Miss

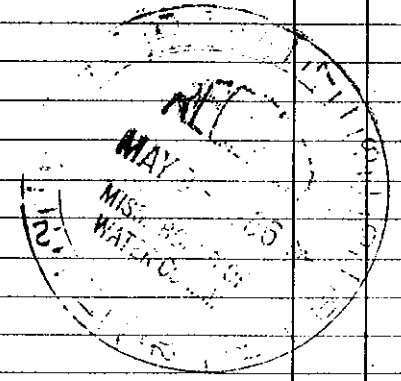

(Use Back Side)

Well No. _____