

**AMITE** MISSISSIPPI BOARD OF WATER COMMISSIONERS

**B13**

**4-26-66**

**WATER WELL DRILLERS LOG**

Date: April 26, 1966, Driller: J. T. Covington County Itasca  
(Name)

		Description & Color of Materials Sand, Clay, Red Clay, Shell, etc.	Thick- ness Feet	Depth Feet
(1) Owner of Land:	<u>J. P. Whittington</u> <small>(Name)</small>	<u>Red Clay</u>	<u>20</u>	<u>20</u>
	<u>Ylster, Miss.</u> <small>(Address)</small>	<u>Sandy Clay</u>	<u>10</u>	<u>30</u>
(2) Location:	<u>1/4, 1/4, Sec. 28 T4R3</u>	<u>Sand</u>	<u>40</u>	<u>70</u>
	<u>11 miles N</u> of <u>Ylster</u> <small>(distance) (direction) (Nearest Town)</small>	<u>Rock + Chalk</u>	<u>5</u>	<u>75</u>
(3) Topography:	<u>Hilly</u> <small>(Hilly) (Flat) (Level)</small>	<u>Sand + Rock</u>	<u>13</u>	<u>88</u>
(4) Purpose of Well:	<u>Domestic</u> <small>(Domestic Irrigation Municipal, Industrial, Other)</small>			


Information upon completion of well:

- (1) Diameter 4" inches.
- (2) Total Depth 88' feet.
- (3) Water Level 75' feet below top of ground.
- (4) Cased to 88', Size 4"
- (5) Screen: Size 4", Length 6'
- (6) Were any formations sealed against pollution?  
 yes,  no.

If YES depth of formation \_\_\_\_\_

Why \_\_\_\_\_

Drillers Remarks: \_\_\_\_\_

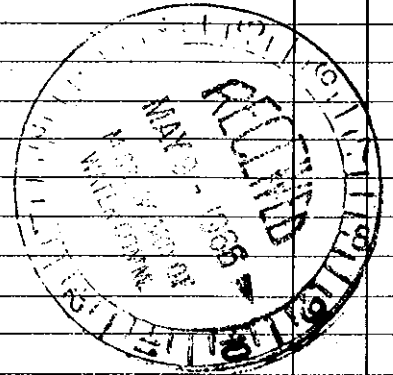

(Use Back Side)

Well No.

Mail this copy to Board of Water Commissioners 429 Miss. St. Jackson, Miss