

AMITE
B14

6-24-66 MISSISSIPPI BOARD OF WATER COMMISSIONERS

WATER WELL DRILLERS LOG


Date: 6-24-66, 1966, Driller: J. J. Ferguson County Amite
(When well drilled) (Name) (Where well is located)

(1) Owner of land:	Description & Color of Materials Sand, Clay, Red Clay, Shell, etc.	Thick- ness Feet	Depth Feet
<u>J. H. Stegling</u> (Name) <u>RT 1 Blotter</u> (Address)	<u>top soft clay</u>	<u>0</u>	<u>10</u>
	<u>Red sand</u>	<u>10</u>	<u>25</u>
	<u>gravel</u>	<u>25</u>	<u>85</u>
(2) Location: <u>SW 1/4, S 1/4, Sec 36 T14N3E</u>	<u>Red chalk</u>	<u>85</u>	<u>95</u>
<u>12</u> miles <u>NW</u> of <u>Liberty</u>	<u>soft gravel</u>	<u>95</u>	<u>135</u>
(distance) (direction) (Nearest Town)	<u>white chalk</u>	<u>135</u>	
(3) Topography: <u>Level</u> (Hilly) (Flat) (Level)			
(4) Purpose of Well: <u>Domestic Irrigation</u> Municipal, Industrial, Other)			

Information upon completion of well:

- (1) Diameter 4 inches.
- (2) Total Depth 134 feet.
- (3) Water Level 90 feet below top of ground.
- (4) Cased to 126, Size 4
- (5) Screen: Size 4, Length 8'
- (6) Were any formations sealed against pollution?
_____ yes, _____ no.

If YES depth of formation _____
Why _____
Drillers Remarks: _____
Yield in gpm: 17
Size pump: 1/2 sub -
Type power: elec

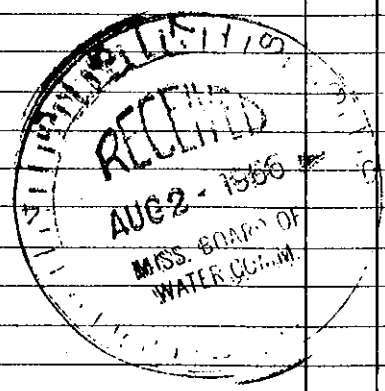

Mail this copy to Board of Water Commissioners 429 Miss. St. Jackson, Miss.