

Amitc
B16
7-66

MISSISSIPPI BOARD OF WATER COMMISSIONERS

WATER WELL DRILLERS LOG

Date: 7-23, 1966, Driller: Perriswell Pump County: Amitc
(When well drilled) (Name) (Where well is located)

| (1) Owner of Land: | | Description & Color of Materials Sand, Clay, Red Clay, Shell, etc. | Thick- ness Feet | Depth Feet |
|---|----------------------------|---|------------------------|---------------|
| <small>(Name)</small> | <small>(Address)</small> | | | |
| <u>Russell Huff</u> | <u>RFD, Gbster-</u> | <u>Red Clay</u> | <u>15</u> | <u>15</u> |
| (2) Location: <u>1/4, 1/4, Sec. 27 T. 4 R. 3</u> | | <u>Red Sand & Gravel</u> | <u>55</u> | <u>70</u> |
| <u>9/2</u> miles <u>N. E.</u> | <u>Gbster</u> | <u>White Chalk</u> | <u>40</u> | <u>110</u> |
| <small>(distance)</small> | <small>(direction)</small> | <small>(Nearest Town)</small> | | |
| (3) Topography: <u>Hilly</u> | <u>Level</u> | <u>fine white sand</u> | <u>21</u> | <u>131</u> |
| <small>(Hilly)</small> | <small>(Flat)</small> | <small>(Level)</small> | | |
| (4) Purpose of Well: <u>Domestic</u> | | | | |
| <small>(Domestic Irrigation Municipal, Industrial, Other)</small> | | | | |

Information upon completion of well:

- (1) Diameter 4 inches.
- (2) Total Depth 131 feet.
- (3) Water Level 90 feet below top of ground.
- (4) Cased to Bottom Size 4"
- (5) Screen: Size 4", Length 6'
- (6) Were any formations sealed against pollution?
 yes, no.

If YES depth of formation _____


Why _____

Drillers Remarks: _____

Yield in gpm: 7

Size pump: 1/2 HP 504

Type power: Elec.

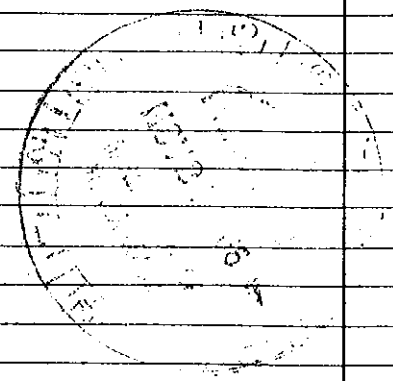

Mail this copy to Board of Water Commissioners 429 Miss. St. Jackson, Miss.