

Amite  
B18  
8-66

MISSISSIPPI BOARD OF WATER COMMISSIONERS

WATER WELL DRILLERS LOG

Date: Aug 23, 1966, Driller: Fernwell Pump County Amite  
(When well drilled) (Name) (Where well is located)

(1) Owner of Land		Description & Color of Materials Sand, Clay, Red Clay, Shell, etc.	Thick- ness Feet	Depth Feet
<u>Eddie H. Williams</u> <small>(Name)</small>	<u>RFD 4, Glaster</u> <small>(Address)</small>	<u>Sandy clay</u>	<u>19</u>	<u>18</u>
		<u>Sand &amp; gravel</u>	<u>10</u>	<u>28</u>
(2) Location: <u>1/4</u> , <u>1/4</u> , Sec. <u>26</u> T. <u>4</u> R. <u>3</u>		<u>Blue chalk</u>	<u>50</u>	<u>78</u>
<u>1 1/2</u> miles <u>N.W.</u> of <u>Busby</u> <small>(distance) (direction) (Nearest Town)</small>		<u>Coarse Sand</u>		<u>1290</u>
(3) Topography: <u>Hilly</u> <small>(Hilly) (Flat) (Level)</small>				
(4) Purpose of Well: <u>Domestic</u> <small>(Domestic Irrigation Municipal, Industrial, Other)</small>				

Information upon completion of well:

- (1) Diameter 4 inches.
- (2) Total Depth 90 feet.
- (3) Water Level 38 feet below top of ground.
- (4) Cased to Bottom Size 4"
- (5) Screen: Size 4", Length 6'
- (6) Were any formations sealed against pollution?  
 yes,  no.

If YES depth of formation \_\_\_\_\_


Why \_\_\_\_\_

Drillers Remarks: \_\_\_\_\_

Yield in gpm: 15

Size pump: 1/2 hp. Jet.

Type power: Electric

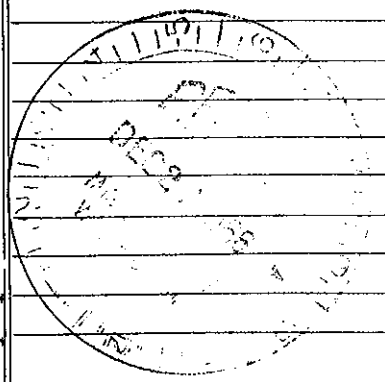

Mail this copy to Board of Water Commissioners 429 Miss. St. Jackson, Miss.