

3DED

Amite
B22
7-67

MISSISSIPPI
BOARD OF WATER COMMISSIONERS
416 North State Street
Jackson, Mississippi 39201

WATER WELL DRILLERS LOG

7-17 date well completed
67 Fitzgerald Water Well Works firm name
Amite county well located


LANDOWNER: Bobby Loremore
Rt 4 Floster, Miss
(mailing address)

WELL LOCATION:
sec 35 T 4 N R 3 E
10 miles N W of Floster
(distance) (direction) (nearest town)

WELL PURPOSE: home
(home, irrigation, municipal, industrial)

- WELL COMPLETION DATA:
- (1) diameter (inches) 4 1/2
 - (2) total depth (feet) 98
 - (3) static water level (feet) 18 below top of ground.
 - (4) casing plastic 92 (material) (depth)
 - (5) screen 4 (length) 92 (depth to top)
 - (6) pump 1/2 HP (type power) 12 (yield gpm)
 - (7) electric log No (yes or no)
 - (8) how well bottom plugged Wood peg

description of formations encountered	from	to
Top soil & clay	0	8
Red gravel	8	12
White chalk	12	16
Fine - medium sand	16	80
Coarse sand	80	98

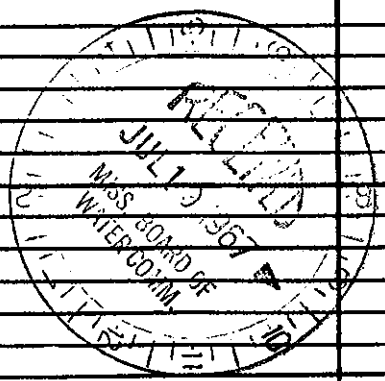

DRILLERS REMARKS: