

Amite
B25
10-67

MISSISSIPPI
BOARD OF WATER COMMISSIONERS
416 North State Street
Jackson, Mississippi 39201

CODE 17

WATER WELL DRILLERS LOG

10-5-1967 date well completed
F. Fitzgerald Well film name
Amite county well located


LANDOWNER: Jake Toney
Floster Rt 1
(mailing address)

description of formations encountered	from	to
	top soil & clay	0
hard sand	20	46
sand & gravel	46	58
chalk	58	84
heavy gravel	84	92
fine sand	92	

WELL LOCATION:
sec 26 T 4 N R 3 E
10 miles N W of Liberty
(distance) (direction) (nearest town)

WELL PURPOSE: HOME
(home, irrigation, municipal, industrial)

- WELL COMPLETION DATA:
- (1) diameter (inches) 4
 - (2) total depth (feet) 92
 - (3) static water level (feet) 12 below top of ground.
 - (4) casing plastic 86 (material) (depth)
 - (5) screen 61 (length) 86 (depth to top)
 - (6) pump (HP) (yield gpm)
 - (7) electric log (yes or no)
 - (8) how well bottom plugged

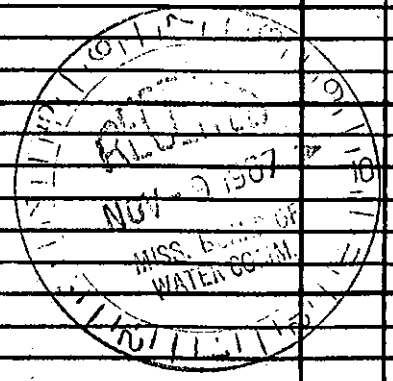

DRILLERS REMARKS: