

Never received Part 2 3/2013

County: Amite
 Permit #: _____
 Driller: Justin Robinson
 Date drilling completed: 7/25/10

State Well Report
Part 1 - Driller's Log
 Mississippi Department of Environmental Quality
 Office of Land and Water Resources
 P.O. Box 2309
 Jackson, MS 39225
 (601)961-5210
 (601)961-5228 (fax)

For Office Use Only:
 Aquifer: B 65
 Well #: _____
 L. S. Elevation: _____
 E-log #: _____

State Law requires that this report be prepared by the license holder responsible for the work and filed with the Department at the above address within 30 days of completion of drilling of the well or borehole.

Information on Well Owner (Landowner if borehole is not for a water well)	Well or Borehole Location
Owner Name: <u>Serry Robertson</u>	Latitude: <u>31 17 59</u> Longitude: <u>90 57 .07</u>
Mailing Address: <u>1060 Tobias Ln</u>	Method of Lat/Long (circle one): Conventional Survey, USGS quad <u>Hand-held GPS</u> Survey-grade GPS
<u>Liberty MS 39645</u> City State Zip Code	USGS quad <u>NW 1/4 NW 19</u> Twn <u>4 N</u> Rng <u>3 E</u>
Telephone No. <u>(523) 429 3552</u>	Distance <u>4</u> Miles <u>east</u> of <u>Liberty</u>

Well / Borehole Data

Date drilling started: 7/24/10 Date drilling completed: 7/25/10 Hole depth: 125 Hole diameter: 6 3/4

Location of the source of any surface water used for drilling: None

Method of dosing and volume of Chlorine used in drilling and development: 7ppm

Logs run (circle all applicable): No log run Electric Gamma Ray Density Sonic Neutron Other: _____

Name of organization running log(s): _____

Purpose of borehole (check one): Water Well Geotechnical/Geological Investigation _____ Ground Source Heat Pump _____
 Seismic Survey _____ Other (describe) _____

If drilling is not related to water well construction, skip the remainder of this block

Purpose of Well (check one): Home Industrial _____ Public Supply _____ Irrigation _____ Fish Culture _____ Other: _____

If a flowing well, method of flow regulation: Valve _____ Other (describe) _____

Static Water Level: 92 feet above or below (circle one) land surface Date measured: 7/25/10

Method of Measurement (circle one) steel tape electric tape air line other: _____

Well depth: 120 Well grouted to a depth of 10 feet Type of grout (circle one): Neat Cement Bentonite Mix

Casing length: 100 feet Casing diameter: 4 inches Type of casing: 4. pvc sch 40 studded

Screen length: 20 feet Screen diameter: 4 inches Type of screen: pvc sch 40 studded

Screen slot size: .010 inches Setting depth: From 120 feet to 100 feet

Type of completion (circle all applicable): Gravel packed Underreamed Telescoped Open hole Natural Development
 Other (describe): _____

Top of lap pipe or reduction in casing: _____ feet. *If telescoped or more than one screen, describe on next page*

Form: OLWR-SWR-1A (04/08)

RECEIVED
 AUG 05 2010
 BY: OLWR


665

The sketch below only required for water wells

Description of formations encountered must be provided for all wells and boreholes, unless specifically exempted by regulations

If well telescopes, show depths on sketch.


Ground Level \rightarrow

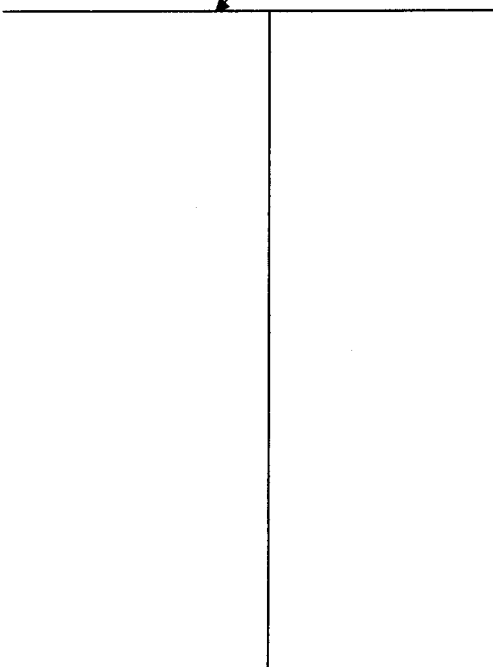

Description of Formations Encountered	From (depth)	To (depth)
red clay and gravel	Ground Level	43
white sands and small gravel	43	100
big gravel	100	120

If more than one screen, show location of each on sketch

Sketch the property layout and include the following: 1) the well location; 2) any permanent structures on the property that may aid in locating the well; 3) any roads, power lines, or other items that may aid in locating the property and the well; 4) a north arrow.

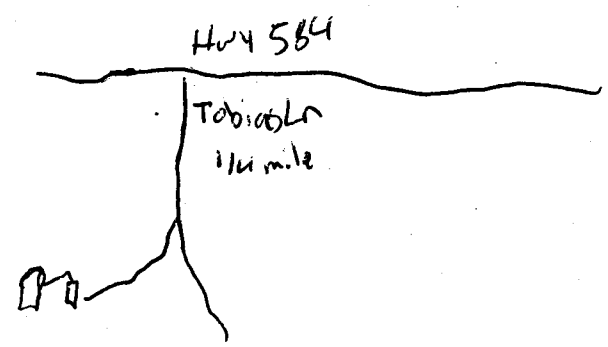

Landowner Name: Jerry Robertson

Form: OLWR-SWR-IA (04/08)

I certify that the well/borehole was drilled, constructed, and completed in accordance with all applicable requirements of the Mississippi Department of Environmental Quality and the Mississippi Department of Health regulations, if applicable, and state laws.

Print Name of Responsible Licensee and License No. Forest W Junior Jr. 2125110

Date

Signature of Licensee

RECEIVED
AUG 05 2010
BY: OLWR