

AMITE MISSISSIPPI BOARD OF WATER COMMISSIONERS


C2
9-7-65

CODE

WATER WELL DRILLERS LOG

Date: 9-7, 1965, Driller: J.T. Covington Sr. County Amite
Rice
(Name)

(1) Owner of Land: <u>Clarence Dillon</u> (Name)	Description & Color of Materials Sand, Clay, Red Clay, Shell, etc.	Thick- ness Feet	Depth Feet
<u>Medville, Miss.</u> (Address)	<u>Sandy Clay</u>	<u>55</u>	<u>55</u>
(2) Location: <u>1/4, 1/4, Sec. 9 T44</u>	<u>sand & Rock</u>	<u>15</u>	<u>70</u>
<u>20</u> miles <u>West</u> of <u>Summit</u> (distance) (direction) (Nearest Town)	<u>Chalk</u>	<u>80</u>	<u>150</u>
(3) Topography: <u>Hilly</u> (Hilly) (Flat) (Level)	<u>Sands</u>	<u>20</u>	<u>170</u>
(4) Purpose of Well: <u>Domestic</u> (Domestic Irrigation Municipal, Industrial, Other)			
Information upon completion of well:			
(1) Diameter <u>4"</u> inches.			
(2) Total Depth <u>170'</u> feet.			
(3) Water Level <u>70'</u> feet below top of ground.			
(4) Cased to <u>170'</u> , Size <u>4"</u>			
(5) Screen: Size <u>4"</u> , Length <u>6'</u>			
(6) Were any formations sealed against pollution?			
_____ yes, <input checked="" type="checkbox"/> no.			
If YES depth of formation _____			
Why _____			
Drillers Remarks: _____			

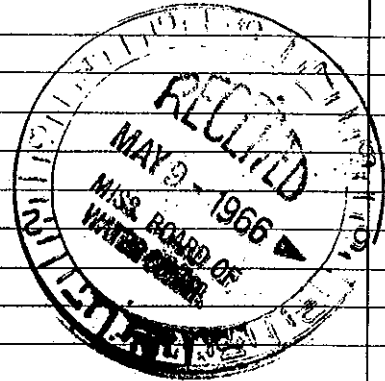

(Use Back Side)

Well No.

Mail this copy to Board of Water Commissioners 429 Miss. St. Jackson, Miss.