

Amite
C7
2-68

MISSISSIPPI
BOARD OF WATER COMMISSIONERS
416 North State Street
Jackson, Mississippi 39201

FOOT

WATER WELL DRILLERS LOG

2-10 1968 *B. A. ...* Amite
date well completed firm name county well located


LANDOWNER: *Sammie Lee White*
Smithdale Rt
Miss.
(mailing address)

description of formations encountered	from
<i>top soil & clay</i>	<i>0 18</i>
<i>gravel</i>	<i>18 52</i>
<i>Chalk</i>	<i>52 90</i>
<i>Coarse sand</i>	<i>90 100</i>
<i>Coarse sand</i>	<i>100 130</i>
<i>Chalk white</i>	<i>130 146</i>

WELL LOCATION:
sec. 11 T. 4 N. R. 14 E. S. 1
13 miles *N* of *Liberty*
(distance) (direction) (nearest town)

WELL PURPOSE:
(home, irrigation, municipal, industrial)

- WELL COMPLETION DATA:
- (1) diameter (inches) 4
 - (2) total depth (feet) 146
 - (3) static water level (feet) 50 below top of ground.
 - (4) casing plastic (material) 140 (depth)
 - 4 (size) if telescope see back.
 - (5) screen 6' (length) 146 (depth to top)
 - 4 (size) Sch 40- (material)
 - (6) pump Steel (type power)
 - (7) electric log NO (yes or no)
 - (organization running log)
 - (8) how well bottom plugged Wood peg

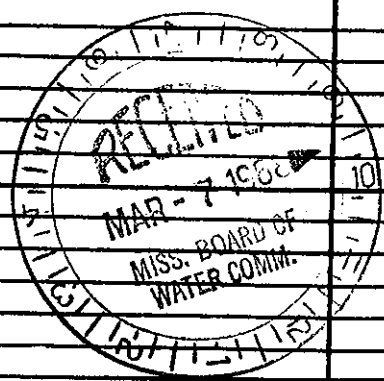

DRILLERS REMARKS: