

AMITE MISSISSIPPI BOARD OF WATER COMMISSIONERS
 OCZI 976
 10-25-65 WATER WELL DRILLERS LOG

CODED

Date: Oct 25, 1965, Driller: Chester Reeves County Amite
 (Name)

(1) Owner of Land: Fredrick M. Arnold
 (Name)
RFD, Liberty
 (Address)
 (2) Location: 1/4, 1/4, Sec. 21, T. 9 R. 4
11 miles N.W. of Liberty
 (Distance) (direction) (Nearest Town)
 (3) Topography: Hilly
 (Hilly) (Flat) (Level)
 (4) Purpose of Well: Domestic
 (Domestic Irrigation, Municipal, Industrial, Other)


Description & Color of Materials Sand, Clay, Red Clay, Shell, etc.	Thick- ness Feet	Depth Feet
<u>Top of hole</u>		<u>15 15</u>
<u>Sandy gravel</u>	<u>43</u>	<u>58</u>
<u>Blue shale</u>	<u>25</u>	<u>83</u>
<u>Coarse white sand</u>	<u>15</u>	<u>98</u>

Information upon completion of well:

(1) Diameter 4 inches.
 (2) Total Depth 324 feet.
 (3) Water Level 155 feet below top of ground.
 (4) Cased to Bottom size 4"
 (5) Screen: Size 4", Length 7'
 (6) Were any formations sealed against pollution?
 _____ yes, no.

If YES depth of formation _____
 Why _____

Driller's Remarks: New
house

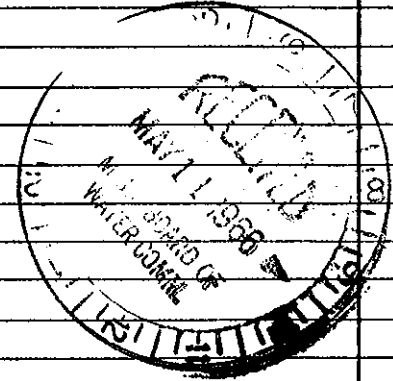

REEVES WELL & PUMP CO.
 P. O. BOX 71 - PHONE 684-1451
 McCOMB, MISS.

(Use Back Side)

Well No.

Mail this copy to Board of Water Commissioners 429 Miss. St. Jackson, Miss.