

AmITE
C22

MISSISSIPPI BOARD OF WATER COMMISSIONERS

1000
WATER WELL DRILLERS LOG

CODED

10-22-63

Date: 10-22, 1963, Driller: Chester Reeves, County Amite

(Name)

(1) Owner of Land: Douglas Coleman
(Name)
RFD - Liberty
(Address)

(2) Location: 1/4, 1/4, Sec. 27 T. 9 R. 4
10 miles N.W. of Liberty
(distance) (direction) (Nearest Town)

(3) Topography: Hilly
(Hilly) (Flat) (Level)

(4) Purpose of Well: Domestic
(Domestic Irrigation
Municipal, Industrial, Other)

Description & Color of Materials Sand, Clay, Red Clay, Shell, etc.	Thick- ness Feet	Dep- th Feet
<u>Red Clay</u>	<u>25-25</u>	
<u>Red Sand</u>	<u>59-84</u>	
<u>gravel & chalk</u>	<u>12-96</u>	
<u>Big gravel with small amount sand</u>	<u>10-112</u>	


Information upon completion of well:

- (1) Diameter 4 inches.
- (2) Total Depth 112 feet.
- (3) Water Level 84 feet below top of ground.
- (4) Cased to bottom Size 4"
- (5) Screen: Size 4", Length 6'
- (6) Were any formations sealed against pollution?
 yes, no.

If YES depth of formation _____

Why _____

Drillers Remarks: old well
Dry.

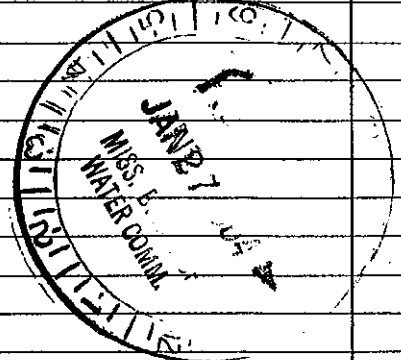

CODED

REEVES WELL & PUMP CO.
 P. O. BOX 71 -- PHONE 684-1451
 McCOMB, MISS.

(Use Back Side)

Well No.