

AMITE  
 C23  
 10-3-67

MISSISSIPPI  
 BOARD OF WATER COMMISSIONERS  
 416 North State Street  
 Jackson, Mississippi 39201

**CODED**

WATER WELL DRILLERS LOG

10-3-67 date well completed      980 67 Fitzgerald Water Well Firm name      F. Amite county well located

LANDOWNER: Troy Beasley  
Rt 3 Liberty  
 (mailing address)


description of formations encountered	from	to
Top Soil & clay	0	25
Sand	25	42
gravel	42	82
Chalk	82	105
gravel & sand	105	116
Chalk	116	142
loose gravel	142	150
Sand progressively coarse	150	194

WELL LOCATION:  
 sec. 22 T 4 S R 4 E  
 (distance) miles (direction) of (nearest town)

WELL PURPOSE: house  
 (home, irrigation, municipal, industrial)

- WELL COMPLETION DATA:
- (1) diameter (inches) 4
  - (2) total depth (feet) 194
  - (3) static water level (feet) 90 below above top of ground.
  - (4) casing plastic 188 (material) (depth)  
4 (size) If telescope see back.
  - (5) screen 6' 188 (length) (depth to top)  
4 (size) plastic (material)
  - (6) pump 1/2 Sub 10 (HP) (yield gpm)  
Elec (type power)
  - (7) electric log NO (yes or no)  
 (organization running log)
  - (8) how well bottom plugged Weld plug

**CODED**

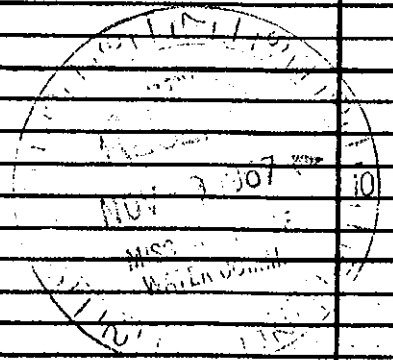

DRILLERS REMARKS: