

County: Amite
 Permit #: _____
 Driller: Fitzgerald Well Service
 Date drilling completed: 8-25-15

State Well Report
Part 1 – Driller’s Log
 Mississippi Department of Environmental Quality
 Office of Land and Water Resources
 P.O. Box 2309
 Jackson, MS 39225
 (601)961- 5210
 (601)961- 5228 (fax)

For Office Use Only:

Aquifer: _____
 Well #: C62
 L. S. Elevation: _____
 E-log #: _____

State Law requires that this report be prepared by the license holder responsible for the work and filed with the Department at the above address within 30 days of completion of drilling of the well or borehole.

<p align="center">Information on Well Owner <i>(Landowner if borehole is not for a water well)</i></p> <p>Owner Name: <u>Roger Walker</u> Mailing Address: <u>Pecan Rd.</u> <u>Smithdale</u> <u>MS</u> City State Zip Code Telephone No. () _____</p>	<p align="center">Well or Borehole Location</p> <p>Latitude: <u>31° 16' 45.3"</u> Longitude: <u>90° 48' 38.6"</u> Method of Lat/Long (circle one): Conventional Survey, USGS quad, Hand-held GPS, Survey-grade GPS <u>NW 1/4 SE 1/4</u> Sec <u>28</u> Twn <u>4N</u> Rng <u>4E</u> Distance Direction Nearest Town _____ Miles _____ of _____</p>
--	--

Well / Borehole Data

Date drilling started: 8-25-15 Date drilling completed: 8-25-15 Hole depth: 180' Hole diameter: 8"
 Location of the source of any surface water used for drilling: _____
 Method of dosing and volume of Chlorine used in drilling and development: _____
 Logs run (circle all applicable): No log run Electric Gamma Ray Density Sonic Neutron Other: _____
 Name of organization running log(s): _____
 Purpose of borehole (check one): Water Well Geotechnical/Geological Investigation _____ Ground Source Heat Pump _____
 Seismic Survey _____ Other (describe) _____
If drilling is not related to water well construction, skip the remainder of this block

Purpose of Well (check one): Home Industrial _____ Public Supply _____ Irrigation _____ Fish Culture _____ Other: _____
 If a flowing well, method of flow regulation: Valve _____ Other (describe) _____
 Static Water Level: 90' feet above or below (circle one) land surface Date measured: 8-25-15
 Method of Measurement (circle one) steel tape electric tape air line other: _____
 Well depth: 180' Well grouted to a depth of 10' feet Type of grout (circle one): Neat Cement Bentonite Mix
 Casing length: 160' feet Casing diameter: 4" inches Type of casing: Pvc
 Screen length: 20' feet Screen diameter: 4" inches Type of screen: Pvc
 Screen slot size: .010 inches Setting depth: From 160' feet to 180' feet
 Type of completion (circle all applicable): Gravel packed Underreamed Telescoped Open hole Natural Development
 Other (describe): _____
 Top of lap pipe or reduction in casing: _____ feet. *If telescoped or more than one screen, describe on next page*

Form: OLWR-SWR-1A (04/08)

RECEIVED
 OCT 06 2015
 OFFICE OF LAND AND WATER RESOURCES

STATE WELL REPORT

Part 2

Pump Installer's Completion Report
 Mississippi Department of Environmental Quality
 Office of Land and Water Resources
 P.O. Box 2309
 Jackson, MS 39225-2309
 (601)961-5210
 (601) 360-0535 (fax)

For Office Use Only:

Well #: C62

Aquifer: _____

County: Amite
 Permit #: _____
 Driller: Fitzgerald Well Service
 Date completed: 8-25-15
Copy information from block on Part 1

This part of the report must be completed by a licensed water well contractor or a licensed pump installer. A copy of Part 1 of the report must be attached and both parts filed with the Department at the above address within 30 days of well completion.

Well Owner Information	Well Location
Owner Name: <u>Roger Walker</u>	Latitude: <u>31° 16' 45.3"</u> Longitude: <u>90° 48' 38.6"</u>
Mailing Address: <u>Pecan Rd.</u>	Method of Lat/Long (check one): Conventional Survey _____
<u>Southdale</u> <u>MS</u>	USGS quad _____, Hand-held GPS _____, Survey-grade GPS _____
City State Zip Code	<u>NW 1/4 SE 1/4, Sec 28 T 4N R 4E</u>
Telephone No. (____) _____	____ Miles ____ of ____ (Distance) (Direction) (Nearest Town)

Pump Type (circle one)

Submersible Turbine Air Lift Centrifugal Flowing Well Jet Piston Rotary Other (describe): _____

Date Pump Installed: 8-25-15 Rated Pump Capacity: 20 Gallons Per Minute

Is This Pump (circle one): New Repaired Replacement

Power Type (circle one)

Electric Diesel Gasoline Natural Gas Tractor PTO Windmill Other (describe): _____

Horse Power Rating of Motor: 1 Setting Depth: 130' feet Number of Stages: 8

Pump Test Data for Non Flowing Well

Date Well Tested: _____ Duration of Pump Test (minimum 4 hours): _____ hours

Static Water Level (A): _____ Feet Below Land Surface Pumping Water Level (B): _____ Feet Below Land Surface

Drawdown [(B) - (A)]: _____ Feet Below Land Surface Test Pumping Rate: _____ Gallons Per Minute

Method of measurement (circle one): Steel tape Electric tape Air line Other (describe): _____

Pump Test Data for Flowing Well

Measured shut in head: _____ feet.

Well yielded _____ GPM with a drawdown of _____ feet after _____ hours of pumping

Meter Installation

Meter Manufacturer: _____ Meter Serial Number: _____

Meter Model Number/Name: _____ Type of Meter: _____

Totalizer Register Unit and Multiplier Factor (AF x .001, gal x 1000, etc): _____

Installation Date: _____ Meter installed by: _____


Is This Meter (circle one): New Repaired Replacement

Important: By submitting the above information you are certifying that this meter was installed to manufacturer standards. For agricultural wells, a list of approved meters is on the MDEQ website.

I HEREBY CERTIFY that the above statements are true to the best of my knowledge.

Bird Fitzgerald 029 8-25-15 Bird Fitzgerald
 Print Name of Pump Installer and License No. (if applicable) Date Signature of Pump Installer

Google Maps 31°16'45.3"N 90°48'38.6"W

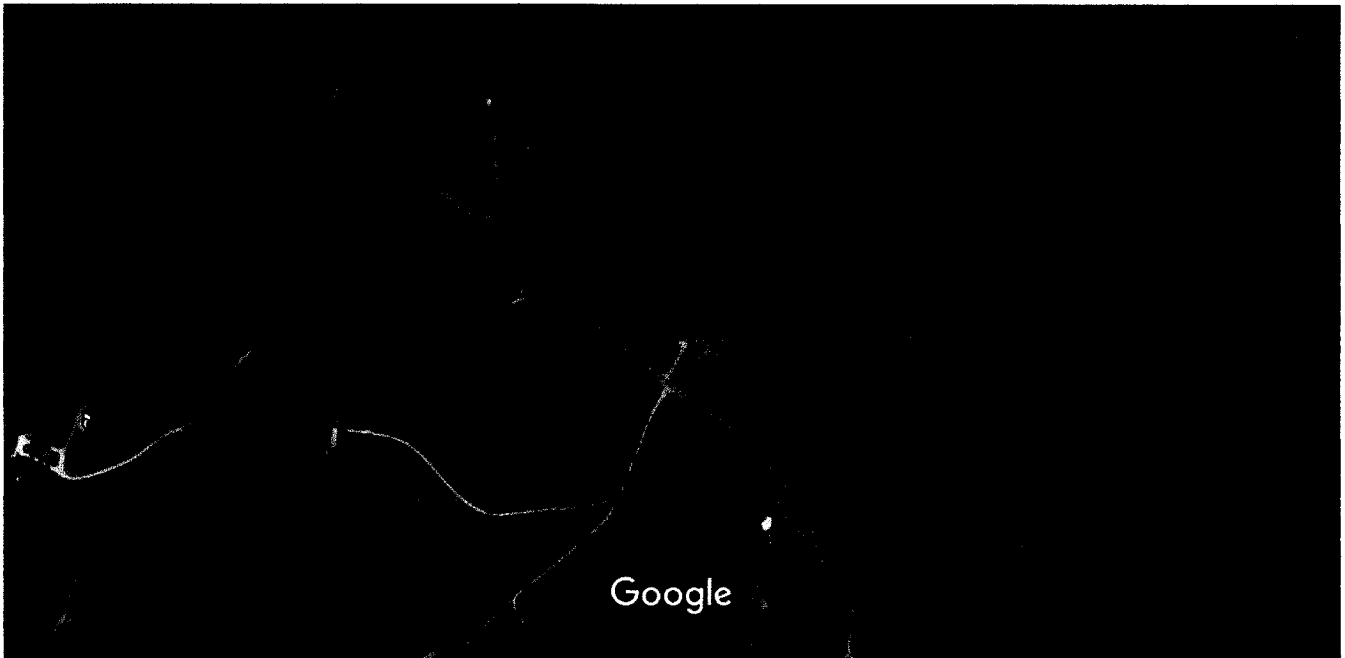

Imagery ©2015 Google, Map data ©2015 Google 200 ft

31°16'45.3"N 90°48'38.6"W

31.279251, -90.810727

APR 2015
OCT 28 2015
31.279251, -90.810727

Roger Walker