


Amite
C 2000
1-29-76

MISSISSIPPI
 BOARD OF WATER COMMISSIONERS
 416 North State Street
 Jackson, Mississippi 39201

WATER WELL DRILLERS LOG

1-29 1976 Fitzgibbon Well Serv Amite
 date well completed firm name county well located

LANDOWNER:	description of formations encountered	from	to
<u>Burnett Cassaway</u>			
<u>R.R. Lehotsky, Inc.</u> (mailing address)	<u>Red sand</u>	<u>20</u>	<u>60</u>
	<u>Red chalk</u>	<u>60</u>	<u>90</u>
	<u>Coarse sand & gravel</u>	<u>90</u>	<u>100</u>
WELL LOCATION:			
sec. <u>31T</u> <u>4(N)</u> <u>S</u> R. <u>4 (E)</u> <u>W</u>			
<u>1</u> miles <u>SE</u> of <u>Bucyrus</u> (distance) (direction) (nearest town)			
WELL PURPOSE: (home, irrigation, municipal, industrial)			
<u>Home</u>			
WELL COMPLETION DATA:			
(1) diameter (inches) <u>4</u>			
(2) total depth (feet) <u>100</u>			
(3) static water level (feet) <u>55</u> below above top of ground.			
(4) casing <u>PVC</u> <u>92</u> (material) (depth)			
<u>4</u> if telescope see back. (size)			
(5) screen <u>8</u> <u>92</u> (length) (depth to top)			
<u>4</u> <u>PVC</u> (size) (material)			
(6) pump <u>1/2</u> <u>10</u> (HP) (yield gpm)			
<u>elec</u> (type power)			
(7) electric log <u>no</u> (yes or no)			
(organization running log)			
(8) how well bottom plugged <u>sealed</u>			

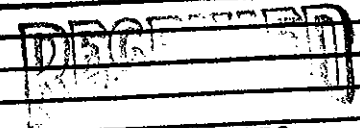

FEB 4 - 1976

MISS. Bd. of WATER COMM

DRILLERS REMARKS: