


AMITE
C 2019
11-29-78

MISSISSIPPI
 BOARD OF WATER COMMISSIONERS
 416 North State Street
 Jackson, Mississippi 39201

WATER WELL DRILLERS LOG

11-29-78 19 19 Fitzgerald Well Service Amite
 date well completed firm name county well located

LANDOWNER:	description of formations encountered	from	to
<u>Thomas Dawson</u>			
<u>RR. 1, Amite, MS</u> (mailing address)	<u>Red clay</u>	<u>0</u>	<u>20</u>
	<u>Red sand & gravel</u>	<u>20</u>	<u>130</u>
	<u>Coarse sand & gravel</u>	<u>130</u>	<u>150</u>
WELL LOCATION:			
sec. <u>38</u> T <u>4</u> N R <u>4</u> E S W			
<u>8</u> miles <u>NW</u> of <u>Liberty</u> (distance) (direction) (nearest town)			
WELL PURPOSE: <u>Home</u> (home, irrigation, municipal, industrial)			
WELL COMPLETION DATA:			
(1) diameter (inches) <u>4</u>			
(2) total depth (feet) <u>150</u>			
(3) static water level (feet) <u>90</u> below above top of ground.			
(4) casing <u>PVC, 142</u> (material) (depth)			
<u>4</u> (size) if telescope see back.			
(5) screen <u>8</u> <u>142</u> (length) (depth to top)			
<u>4</u> <u>PVC</u> (size) (material)			
(6) pump <u>1/2</u> <u>10</u> (HP) (yield gpm)			
<u>Electric</u> (type power)			
(7) electric log <u>No</u> (yes or no)			
(organization running log)			
(8) how well bottom plugged <u>Level Shit</u>			
DRILLERS REMARKS:			

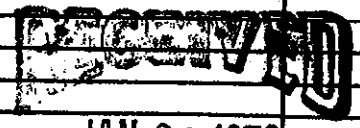

JAN 26 1978

MISS. BD. OF WATER COMM