

Amite
C 2051

MISSISSIPPI DEPARTMENT OF NATURAL RESOURCES
Bureau of Land and Water Resources
Southport Mall
P.O. Box 10631
Jackson, Mississippi 39209
WATER WELL DRILLERS LOG


Oct 31 1987 F. Greenbacker, Inc. Amite
date well completed firm name county well located

LANDOWNER:	description of formations encountered	from	to
<u>Thomas Murray</u>			
<u>R.H. Smithdale, Mrs.</u> (mailing address)	<u>Red Clay</u>	<u>0</u>	<u>12</u>
	<u>Red Sand</u>	<u>12</u>	<u>85</u>
	<u>Coarse sand & gravel</u>	<u>85</u>	<u>103</u>

WELL LOCATION:
sec. 14 T 4 N R 4 E
S W
4 miles W of Fennestown
(distance) (direction) (nearest town)

WELL PURPOSE: Home
(home, irrigation, municipal, industrial)

- WELL COMPLETION DATA:
- (1) diameter (inches) 4
 - (2) total depth (feet) 103
 - (3) static water level (feet) 83 below top of ground.
 - (4) casing MPC, 93
(material) (depth)
4 If telescope see back.
(size)
 - (5) screen 10, 93
(length) (depth to top)
4, MPC
(size) (material)
 - (6) pump 1/2, 10
(HP) (yield gpm)
elec
(type power)
 - (7) electric log no
(yes or no)
(organization running log)
 - (8) how well bottom plugged bad plug

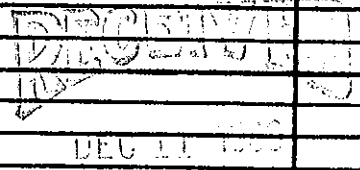

Department of Natural Resources
Bureau of Land & Water Resources

DRILLERS REMARKS: