

AMITE MISSISSIPPI BOARD OF WATER COMMISSIONERS


D3

8-27-65

WATER WELL DRILLERS LOG

Date: 8-27, 1965, Driller: J. T. Cowart ~~County~~ Rich
(Name)

(1) Owner of Land: <u>L.C. Townsend</u> <small>(Name)</small>	Description & Color of Materials Sand, Clay, Red Clay, Shell, etc.	Thick- ness Feet	Depth Feet
<u>Smithdale Miss.</u> <small>(Address)</small>	<u>Sandy Clay</u>	<u>70</u>	<u>70</u>
(2) Location: <u>1/4, 1/4, Sec. 9 T4R5</u>	<u>SANDY ROCK</u>	<u>15</u>	<u>85</u>
<u>15</u> miles <u>W 1/2 W</u> of <u>Summit</u> <small>(distance) (direction) (Nearest Town)</small>	<u>Chalk</u>	<u>60</u>	<u>145</u>
(3) Topography: <u>Hilly</u> <small>(Hilly) (Flat) (Level)</small>	<u>SANDS</u>	<u>25</u>	<u>170</u>
(4) Purpose of Well: <u>Domestic</u> <small>(Domestic Irrigation Municipal, Industrial, Other)</small>			
Information upon completion of well:			
(1) Diameter <u>4"</u> inches.			
(2) Total Depth <u>170'</u> feet.			
(3) Water Level <u>85</u> feet below top of ground.			
(4) Cased to <u>170</u> , Size <u>4"</u>			
(5) Screen: Size <u>4"</u> , Length <u>6'</u>			
(6) Were any formations sealed against pollution?			
_____ yes, <input checked="" type="checkbox"/> no.			
If YES depth of formation _____			
Why _____			
Drillers Remarks: _____			

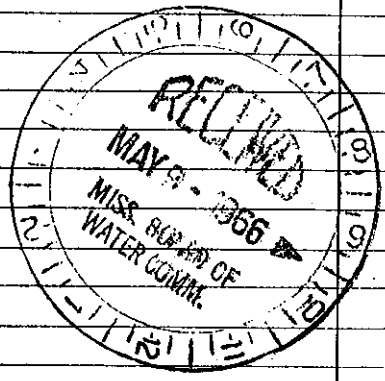

(Use Back Side)

Well No.

Mail this copy to Board of Water Commissioners 429 Miss. St. Jackson. Miss.