


AMITE MISSISSIPPI BOARD OF WATER COMMISSIONERS
 D4
 10-1-65 WATER WELL DRILLERS LOG CODED

Date: Oct 1, 1965, Driller: J. T. Cooneyton, Sr. County: Pike
 (Name)

	Description & Color of Materials Sand, Clay, Red Clay, Shell, etc.	Thick- ness Feet	Depth Feet
(1) Owner of Land: <u>H. A. Young</u> (Name) <u>Smithdale, Miss.</u> (Address)	<u>Sandy Clay</u>	<u>60</u>	<u>60</u>
(2) Location: <u>1/4</u> , <u>1/4</u> , Sec. <u>3</u> T <u>4</u> R <u>5</u> , <u>1</u> miles <u>West</u> , of <u>Smithdale</u> , (distance) (direction) (Nearest Town)	<u>SAND & ROCK</u> <u>STREAKS OF CHALK</u>	<u>55</u>	<u>115</u>
(3) Topography: <u>Hilly</u> (Hilly) (Flat) (Level)	<u>SANDS</u>	<u>19</u>	<u>134</u>
(4) Purpose of Well: <u>Domestic</u> (Domestic Irrigation Municipal, Industrial, Other)			
Information upon completion of well:			
(1) Diameter <u>4"</u> inches.			
(2) Total Depth <u>134</u> feet.			
(3) Water Level <u>90'</u> feet below top of ground.			
(4) Cased to <u>134</u> , Size <u>4"</u>			
(5) Screen: Size <u>4"</u> , Length <u>6'</u>			
(6) Were any formations sealed against pollution? <u>no.</u>			
If YES depth of formation _____			
Why _____			
Drillers Remarks: _____			

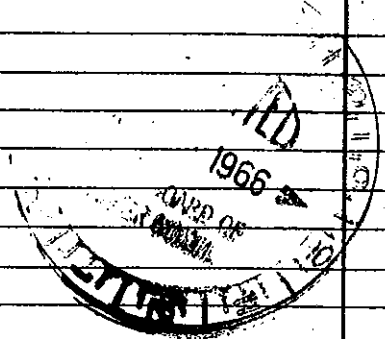

(Use Back Side)

Well No.

Mail this copy to Board of Water Commissioners 429 Miss. St. Jackson, Miss.