

Amite
D7
9-66

MISSISSIPPI BOARD OF WATER COMMISSIONERS

CODED

WATER WELL DRILLERS LOG

Date: ~~966~~ 966, Driller: Eric Fitzgerald County Amite
(When well drilled) (Name) (Where well is located)

(1) Owner of Land: Sr. Andrews
(Name)
~~Smithdale~~
(Address)
(2) Location: NW 1/4, NE 1/4, Sec 1 T 4 R 5
12 miles NE of Liberty
(distance) (direction) (Nearest Town)
(3) Topography: X
(Willy) (Flat) (Level)
(4) Purpose of Well: Domestic
(Domestic Irrigation
Municipal, Industrial, Other)

Description & Color of Materials Sand, Clay, Red Clay, Shell, etc.	Thick- ness Feet	Depth Feet
<u>Red Clay</u>	<u>0</u>	<u>10</u>
<u>Silver Red sand</u>	<u>10</u>	<u>70</u>
<u>Red clay & sand</u>	<u>70</u>	<u>170</u>
<u>Thin sand</u>	<u>110</u>	<u>125</u>
<u>Coarse sand</u>	<u>125</u>	<u>134</u>

Information upon completion of well:

(1) Diameter 4 inches.
(2) Total Depth 134 feet.
(3) Water Level 40 feet below top of ground.
(4) Cased to 126, Size 4"
(5) Screen: Size 4", Length 8"
(6) Were any formations sealed against pollution?
____ yes, X no.

If YES depth of formation _____


Why _____

Drillers Remarks: _____

Yield in gpm: 40 Gpm

Size pump: 3/4 hp

Type power: Elec

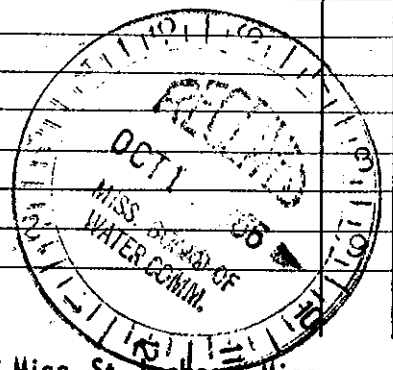

Mail this copy to Board of Water Commissioners 429 Miss. St. Jackson, Miss.