

Amite
 D11
 5-67

MISSISSIPPI
 BOARD OF WATER COMMISSIONERS
 416 North State Street
 Jackson, Mississippi 39201

MODEL

WATER WELL DRILLERS LOG

5-8-1967 date well completed
 67 Filmerold Water Service Amite firm name
 county well located


LANDOWNER: L.S. Jackson
 Smithdale Rt 2
 MISS (mailing address)

description of formations encountered	from	to
Top Soil / Clay	0	12
Sand	12	36
Sand + gravel	36	52
gravel / quartz	52	77
Rock	77	78
Shale + Sand Brown	78	91
Rock	91	-

WELL LOCATION:
 sec. 6 T. 4 N. R. 9 E. S. W.
 4 miles W of Smithdale (distance) (direction) (nearest town)

WELL PURPOSE: home (home, irrigation, municipal, industrial)

- WELL COMPLETION DATA:
- (1) diameter (inches) 4
 - (2) total depth (feet) 91
 - (3) static water level (feet) 75 below top of ground.
 - (4) casing plastic, 85 (material) (depth)
 4" (size) If telescope see back.
 - (5) screen 6' 85 (length) (depth to top)
 4" plastic (size) (material)
 - (6) pump 1/2 HP 12 (HP) (yield gpm)
 Elec (type power)
 - (7) electric log NO (yes or no)
 (organization running log)
 - (8) how well bottom plugged well plug

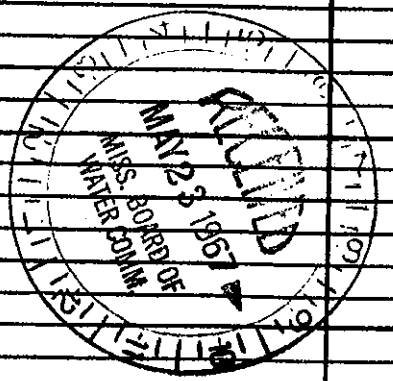

DRILLERS REMARKS: