

AMITE
D29

MISSISSIPPI BOARD OF WATER COMMISSIONERS
4100

1-9-62

WATER WELL DRILLERS LOG

CODED

Date: 1-9, 1962, Driller: *Chester Reeves* County: *Amite*
(Name)

(1) Owner of Land (Name)	Description & Color of Materials Sand, Clay, Red Clay, Shell, etc.	Thick- ness Feet
<i>Lawrence Robinson</i> (Address) <i>Sm. Hodge</i>	<i>Clay 0-20</i>	<i>20</i>
(2) Location: $\frac{1}{4}$, $\frac{1}{4}$, Sec. <i>36 T4 R5</i>	<i>Red Sand 20-45</i>	<i>25</i>
_____ miles _____ of _____ (distance) (direction) (Nearest Town)	<i>Gravel Sand 45-55</i>	<i>10</i>
(3) Topography: <i>Hilly</i> (Hilly) (Flat) (Level)	<i>Sup. Sand 55-70</i>	<i>15</i>
(4) Purpose of Well: <i>Domestic</i> (Domestic Irrigation Municipal, Industrial, Other)	<i>Coarse Sand 70-81</i>	<i>11</i>

Information upon completion of well:


- (1) Diameter *4* inches.
- (2) Total Depth *81* feet.
- (3) Water Level *38* feet below top of ground.
- (4) Cased to *bottoms* Size *4"*
plastic
- (5) Screen: Size *4"*, Length *4'*
- (6) Were any formations sealed against pollution?
_____ yes, no.

If YES depth of formation _____

Why _____

Drillers Remarks: *off well*
Bad.

CODED

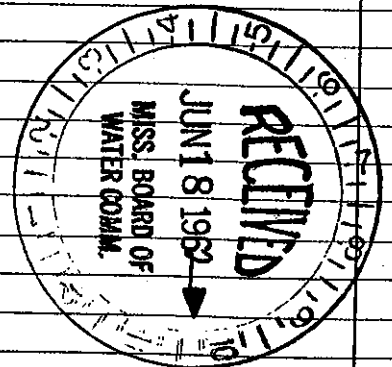

(Use Back Side)

Mail this copy to Board of Water Commissioners 429 Miss. St. Jackson.