

AMITE
D50
12-22-73

MISSISSIPPI
BOARD OF WATER COMMISSIONERS
416 North State Street
Jackson, Mississippi 39201

CODED

WATER WELL DRILLERS LOG

Dec 22 1973 date well completed
Chesters Reeves firm name
Amite county well located


LANDOWNER	description of formations encountered	from	to
RFD Smithdale (mailing address)	Red Clay	0	17
	Red Sand	17	80
	Sand & gravel	80	93
	Red chert	93	96
	Red sand & gravel	96	105

WELL LOCATION:
sec 26 T 4 N R 5 E
2 1/2 miles SW Smithdale
(distance) (direction) (nearest town)

WELL PURPOSE: Home
(home, irrigation, municipal, industrial)

- WELL COMPLETION DATA:
- (1) diameter (inches) 4"
 - (2) total depth (feet) 105
 - (3) static water level (feet) 81 below top of ground
 - (4) casing (material) Plastic Ballast (depth)
 - (5) screen (size) 6' (length) 99' (depth to top)
 - (6) pump (HP) 1/2 (yield gpm) 100 (type power) Electric
 - (7) electric log NO (yes or no)
 - (8) how well bottom plugged water plug

CODED

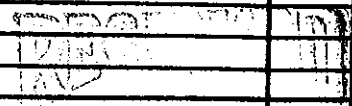

MAY 24 1974

DRILLERS REMARKS:
To be pulled not sufficient