

AMITE
D54
11-21-74

MISSISSIPPI
 BOARD OF WATER COMMISSIONERS
 416 North State Street
 Jackson, Mississippi 39201

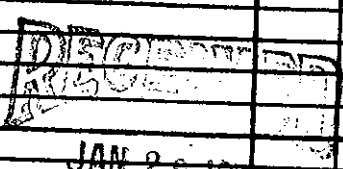
CODED

WATER WELL DRILLERS LOG

21 Nov 1974 date well completed
 J.T. Colington firm name
 Amite county well located

LANDOWNER:
 Robert W. W. W.
 Smithdale Miss.
 (mailing address)

WELL LOCATION:
 sec. 18 T. 4 N R. 2 E
 3 miles N of Smithdale
 (distance) (direction) (nearest town)

description of formations encountered	from	to
Clay	0	20
Chalk	20	45
Sand	45	75
Clay	75	80
Sand	80	134
CODED		
		
MISS. BD. OF WATER COMM		

WELL PURPOSE:
 (home, irrigation, municipal, industrial)

WELL COMPLETION DATA:

(1) diameter (inches) 4

(2) total depth (feet) 134

(3) static water level (feet) 20 below top of ground

(4) casing (material) PL (depth) 128
 (size) if telescope see back.

(5) screen (length) 6 (depth to top) 128
 (size) 4 (material) PL

(6) pump (HP) 1/2 (yield gpm) 8
 (type power) electric

(7) electric log (yes or no)

(organization running log)

(8) how well bottom plugged good

DRILLERS REMARKS: