


AMITE
D 2024
7-9-80
July 9 1980

MISSISSIPPI
BOARD OF WATER COMMISSIONERS
416 North State Street
Jackson, Mississippi 39201

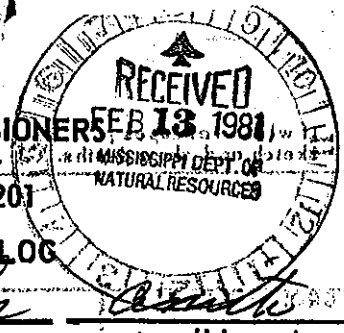

WATER WELL DRILLERS LOG

firm name: Reems Well Co county well located: Amite
date well completed: July 9 1980

LANDOWNER: Clarence Jackson
Mt Smithdale
(mailing address)

description of formations encountered	from	to
<u>red clay</u>	<u>0</u>	<u>17</u>
<u>red sand & clay</u>	<u>17</u>	<u>80</u>
<u>big gravel</u>	<u>80</u>	<u>100</u>

WELL LOCATION:
sec 24 T 4 N R 5 E
2 miles South of Smithdale
(distance) (direction) (nearest town)

WELL PURPOSE: home
(home, irrigation, municipal, industrial)

- WELL COMPLETION DATA:
- (1) diameter (inches) 4"
 - (2) total depth (feet) 100'
 - (3) static water level (feet) 76' below above top of ground.
 - (4) casing Plastic bottom
(material) (depth)
 - (size) 5" if telescope see back.
 - (5) screen 5' 95'
(length) (depth to top)
 - (size) 4" (material) Plastic
 - (6) pump 3/4 1.0
(HP) (yield gpm)
 - (type power) elect
 - (7) electric log no
(yes or no)
 - (organization running log)

(8) how well bottom plugged: Backwash Valve

DRILLERS REMARKS:

DEPT. OF NATURAL RESOURCES
BUREAU OF LAND & WATER RESOURCES

FEB 13 1981

RECEIVED