

AMITE MISSISSIPPI BOARD OF WATER COMMISSIONERS

E⁴
5-6-61

WATER WELL DRILLERS LOG

F-501
RECORDED

Date: 5-6, 1961, Driller: Chester Reeves County: Amite
(Name)

(1) Owner of Land: (Name) (Address)	Description & Color of Materials Sand, Clay, Red Clay, Shell, etc.	Thick- ness Feet	Depth Feet
<u>Wesley DeLong</u> <u>RTD Summit</u>	<u>Yellow Clay</u>	<u>12</u>	<u>12</u>
(2) Location: <u>1/4</u> , <u>1/4</u> , Sec. <u>2</u> T <u>4</u> R <u>6</u> <u>9</u> miles <u>West</u> of <u>Summit</u> (distance) (direction) (Nearest Town)	<u>Red Clay</u>	<u>10</u>	<u>22</u>
(3) Topography: <u>Hilly</u> (Hilly) (Flat) (Level)	<u>Red Sand</u>	<u>10</u>	<u>32</u>
(4) Purpose of Well: <u>Industrial</u> (Domestic Irrigation Municipal, Industrial, Other)	<u>Yellow Sand</u>	<u>16</u>	<u>48</u>
	<u>Sand & Gravel</u>	<u>16</u>	<u>64</u>
	<u>Yellow Sand</u>	<u>27</u>	<u>91</u>
	<u>Sand & Clay</u>	<u>27</u>	<u>118</u>
	<u>Reddish sand</u>	<u>6</u>	<u>124</u>


Information upon completion of well:

- (1) Diameter 3 inches.
 (2) Total Depth 81 feet.
 (3) Water Level 65 feet below top of ground.
 (4) Cased to 75, Size 3"
 (5) Screen: Size 1 1/4, Length 6
 (6) Were any formations sealed against pollution?
 _____ yes, _____ no.

If YES depth of formation _____

Why _____

Drillers Remarks: Made for
Sun Oil Co. for
Testing -

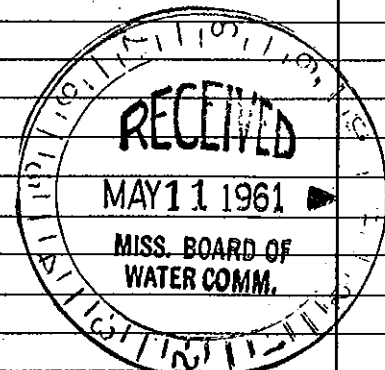

REEVES WELL AND PUMP CO.
Phone 1250
McCOMB, MISSISSIPPI

Well No.

(Use Back Side)

Mail this copy to Board of Water Commissioners 429 Miss. St. Jackson, Miss