

AMITE MISSISSIPPI BOARD OF WATER COMMISSIONERS


E6

1-19-65 WATER WELL DRILLERS LOG

CODED

Date: 1-19, 1965, Driller: *Charles Kelley* County: *Amite*
(Name)

(1) Owner of Land:	Description & Color of Materials Sand, Clay, Red Clay, Shale, etc.	Thick- ness Feet	Depth Feet
<i>Cresley Dixon</i> (Name) <i>Summit #19</i> (Address)	<i>Yellow clay</i>	<i>10</i>	<i>0</i>
(2) Location: $\frac{1}{4}$, $\frac{1}{4}$, Sec. <i>2</i> T. <i>4R6</i> , <i>9</i> miles <i>West</i> of <i>Summit</i> , (distance) (direction) (Nearest Town)	<i>Red clay</i>	<i>15</i>	<i>25</i>
(3) Topography: <i>Hilly</i> (Hilly) (Flat) (Level)	<i>Red sand</i>	<i>35</i>	<i>60</i>
(4) Purpose of Well: <i>Domestic</i> (Domestic Irrigation Municipal, Industrial, Other)	<i>Small brown sand</i>	<i>45</i>	<i>105</i>
Information upon completion of well:	<i>Small brown sand</i>	<i>5</i>	<i>110</i>
(1) Diameter <i>4"</i> inches.	<i>Small brown sand</i>	<i>9</i>	<i>119</i>
(2) Total Depth <i>119</i> feet.			
(3) Water Level <i>69</i> feet below top of ground.			
(4) Cased to <i>Bottom</i> 4			
(5) Screen: Size <i>4"</i> , Length <i>7</i>			
(6) Were any formations sealed against pollution? ____ yes, <input checked="" type="checkbox"/> no.			
If YES depth of formation _____			
Why _____			
Drillers Remarks: <i>set well</i> <i>heavy water</i>			

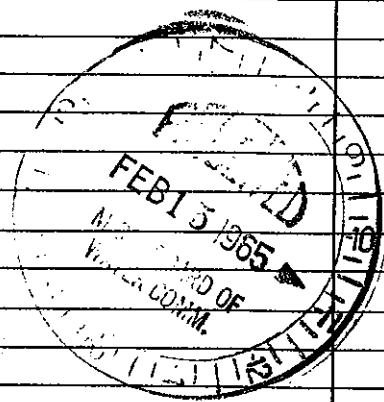

REEVES WELL & PUMP CO.
P. O. BOX 71 - PHONE 884-1651

Well No.

(Use Back Side)

Mail this copy to Board of Water Commissioners 429 Miss. St. Jackson, Miss.