

E8

7-30-62

WATER WELL DRILLERS LOG

CODED

Date: 7-30, 1962, Driller: Chester Reeves County Amite
(Name)

(1) Owner of Land	Description & Color of Materials (Sand, Clay, Red Clay, Shell, etc.)	Thick- ness Feet	Depth Feet
Geo. M. Coy (Name) RFD, Smithdale (Address)	Red clay	20	20
(2) Location: 1/4, 1/4, Sec 20 4 R6 12 miles west of Mt. Comb (distance) (direction) (Nearest Town)	Red chalky sand & gravel white chalk	30	50
(3) Topography: Hilly (Hilly) (Flat) (Level)	Coarse sand & silt gravel	50	100
(4) Purpose of Well: Domestic (Domestic Irrigation Municipal, Industrial, Other)		8	108

Information upon completion of well:


- (1) Diameter 4 inches.
- (2) Total Depth 108 feet.
- (3) Water Level _____ feet below top of ground.
- (4) Cased to Bottom, Size 4"
- (5) Screen: Size 4", Length 4'
- (6) Were any formations sealed against pollution?
_____ yes, no.

If YES depth of formation _____

Why _____

Drillers Remarks: This is an

Additional well -

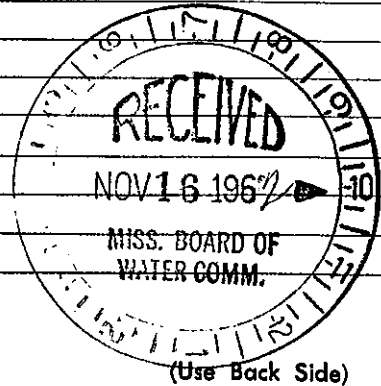

Well No.

Mail this copy to Board of Water Commissioners 429 Miss. St. Jackson, Miss