

AMIT MISSISSIPPI BOARD OF WATER COMMISSIONERS

E 9

10-12-62

WATER WELL DRILLERS LOG

CODED

Date: 10-12, 1962 Driller: Chester Reeves County: Amite

(Name)

		Description & Color of Materials (Sand, Clay, Red Clay, Shell, etc.)	Thick- ness Feet	Depth Feet
(1) Owner of Land:	Ed Mitchell (Name) RFD, Smithdale - (Address)	Red Clay	15	15
(2) Location:	1/4, 1/4, Sec. 17, T4 R6 2 miles north of Smithdale (distance) (direction) (Town)	Red sand Small gravel & sand Red chalk	40 10 5	55 65 70
(3) Topography:	Hilly (Hilly) (Flat) (Level)	Small hard gravel & sand	10	80
(4) Purpose of Well:	Domestic (Domestic Irrigation Municipal, Industrial, Other)			


Information upon completion of well:

- (1) Diameter: 4 inches.
- (2) Total Depth: 80 feet.
- (3) Water Level: 55 feet below top of ground.
- (4) Cased to: Bottom, Size 4"
- (5) Screen: Size 4", Length 4'
- (6) Were any formations sealed against pollution?
 yes, no.

If YES depth of formation

Why

Drillers Remarks: self well
bad.

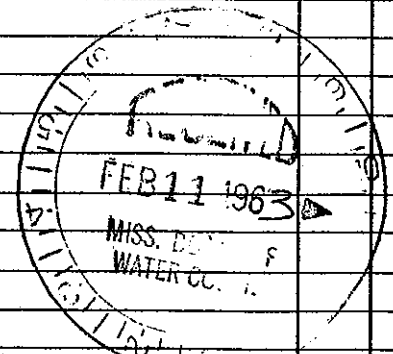

REEVES WELL & PUMP CO.
P. O. BOX 71 -- PHONE 684-1451
MCCOMB, MISS.

(Use Back Side)

Well No.

Mail this copy to Board of Water Commissioners 429 Miss. St. Jackson, Miss.