

E AMITE

WATER WELL DRILLERS LOG

Date: 6-26-63

Driller: Chester Reeves

CODED

County: Amite

(1) Owner of Land: Mrs. Lelia Martin
 (Name)
 Smithdale
 (Address)

(2) Location: 1/4, 1/4, Sec. 4, 4, SE
 2 miles south of Smithdale
 (distance) (direction) (Nearest Town)


(3) Topography: Hilly
 (Hilly) (Flat) (Level)

(4) Purpose of Well: Domestic
 (Domestic Irrigation
 Municipal, Industrial, Other)

Description & Color of Materials Sand, Clay, Red Clay, Shell, etc.	Thick- ness Feet	Dep- th Feet
Red Surface Clay	15	15
Chalky sand	80	95
Sand & gravel	10	105

Information upon completion of well:

- (1) Diameter 2 inches.
- (2) Total Depth 105 feet.
- (3) Water Level 75 feet below top of ground.
- (4) Cased to Bottom, Size 2'
- (5) Screen: Size 1/4, Length 6'
- (6) Were any formations sealed against pollution?
 yes, no.

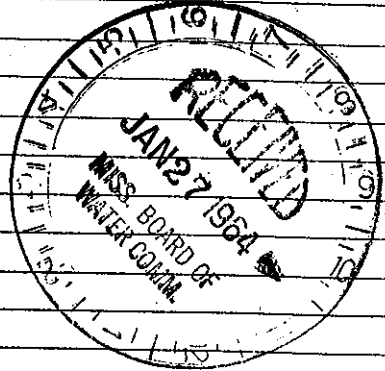

If YES depth of formation _____

Why _____

Drillers Remarks: good well
 Bad

REEVES WELL & PUMP CO.
 P. O. BOX 71 PHONE 684-1451
 McCOMB, MISS.

Retain this copy for your office files.

(Use Back Side)

Well N