

AMITE MISSISSIPPI BOARD OF WATER COMMISSIONERS

E 12

4245

CODED

4-24-64 WATER WELL DRILLERS LOG

Date: 4-24, 1964, Driller: Chester Reeves County Amite
(Name)

	Description & Color of Materials Sand, Clay, Red Clay, Shell, etc.	Thick- ness Feet	Depth Feet
(1) Owner of Land: <u>Bob Brewer</u> (Name) <u>Smithdale</u> (Address)	<u>Surface clay</u>	<u>10</u>	<u>10</u>
(2) Location: <u>1/4, 1/4, Sec. 20 T 4 R 6</u> <u>4</u> miles <u>East</u> of <u>Smithdale</u> (distance) (direction) (Nearest Town)	<u>Seal & gravel</u> <u>clay</u> <u>sand & gravel</u> <u>with gravel</u>	<u>25</u> <u>15</u> <u>4</u>	<u>35</u> <u>50</u> <u>54</u>
(3) Topography: <u>Hilly</u> (Hilly) (Flat) (Level)	<u>blue chalk</u>	<u>57</u>	<u>105</u>
(4) Purpose of Well: <u>Domestic</u> (Domestic Irrigation Municipal, Industrial, Other)	<u>base sand</u> <u>& small pebbles</u> <u>gravel</u>	<u>17</u>	<u>122</u>

Information upon completion of well:

(1) Diameter 4 inches.

(2) Total Depth 122 feet.

(3) Water Level 54 feet below top of ground.

(4) Cased to Bottom Size 4"

(5) Screen: Size 4", Length 7'

(6) Were any formations sealed against pollution?
_____ yes, _____ no.


If YES depth of formation _____

Why _____

Drillers Remarks: New House

CODED

REEVES WELL & PUMP CO.
P. O. BOX 71 PHONE 88-1451
McCOMB, MISS.

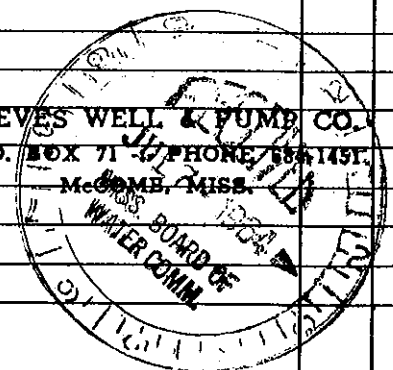

(Use Back Side)

Well No.

Mail this copy to Board of Water Commissioners 429 Miss. St. Jackson, Miss