

AMITE MISSISSIPPI BOARD OF WATER COMMISSIONERS

E 13

12-7-64

WATER WELL DRILLERS LOG

CODED

Date: 12-7-64, Driller: Chester Reeves County Amite

(Name)

(1) Owner of Land	Description & Color of Materials Sand, Clay Red Clay, Shell, etc.	Thick- ness Feet	Depth Feet
George McRay - RFD Smithdale (Address)	Clay sand Red sand Chalk	18 39 38	18 57 95
(2) Location: 1/4, 1/4, Sec. 20 T 4 R 6 5 miles East Smithdale (distance) (direction) (Nearest Town)	Sand & gravel	14	109
(3) Topography: Hill (Hills) Flat (Level)			
(4) Purpose of Well: Chicken house (Domestic Irrigation Municipal, Industrial, Other)			

CODED


Information upon completion of well:

- (1) Diameter 4" inches.
- (2) Total Depth 109 feet.
- (3) Water Level 50 feet below top of ground.
- (4) Cased to bottom Size 4'
- (5) Screen: Size 4', Length 7'
- (6) Were any formations sealed against pollution?
yes, no.

If YES depth of formation _____

Why _____

Drillers Remarks: needed
an extra well
for laying pens

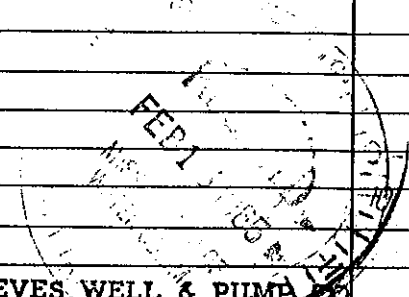

REEVES WELL & PUMP CO
P. O. BOX 71 - PHONE 684-1451
McCOMB, MISS.

Well No.

(Use Back Side)

Mail this copy to Board of Water Commissioners 429 Miss. St. Jackson, Miss.