

Amite  
E16  
10-66


MISSISSIPPI BOARD OF WATER COMMISSIONERS

WATER WELL DRILLERS LOG

CODED

Date: 26 Oct, 1966, Driller: J. T. Crompton County Amite  
(Name)

		Description & Color of Materials Sand, Clay, Red Clay, Shell, etc.	Thick- ness Feet	Depth Feet
(1) Owner of Land: <u>Will Butcher</u> (Name)				
<u>Summit</u> (Address)		<u>clay</u>	<u>30</u>	<u>30</u>
(2) Location: <u>SE 1/4, NE 1/4, Sec. 3 T. 4 R. 6</u>		<u>clay chalk</u>	<u>35</u>	<u>65</u>
<u>6</u> miles <u>west</u> , of <u>Summit</u> (distance) (direction) (Nearest Town)		<u>sand chalk</u>	<u>20</u>	<u>85</u>
(3) Topography: <input checked="" type="checkbox"/> (Hilly) <input type="checkbox"/> (Flat) <input type="checkbox"/> (Level)		<u>ford</u>	<u>21</u>	<u>106</u>
(4) Purpose of Well: <u>Domestic</u> (Domestic Irrigation, Municipal, Industrial, Other)				
Information upon completion of well:				
(1) Diameter <u>4</u> inches.				
(2) Total Depth <u>106</u> feet.				
(3) Water Level <u>85</u> feet below top of ground.				
(4) Cased to <u>106'</u> , Size <u>4"</u>				
(5) Screen: Size <u>4"</u> , Length <u>6'</u>				
(6) Were any formations sealed against pollution? _____ yes, <input checked="" type="checkbox"/> no.				
If YES depth of formation _____				
Why _____				
Drillers Remarks: _____				

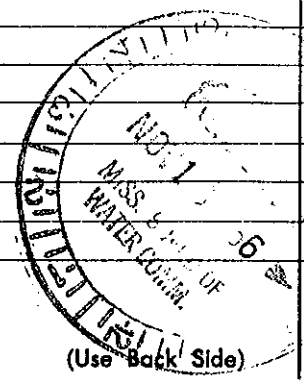

Well No.

Mail this copy to Board of Water Commissioners 429 Miss. St. Jackson, Miss