

Amite
E 17
9-66

MISSISSIPPI BOARD OF WATER COMMISSIONERS

CODED

WATER WELL DRILLERS LOG

Date Sept 4, 1966, Driller Keenes well & Pump County Amite
(When well drilled) (Name) (Where well is located)

(1) Owner of Land		Description & Color of Materials sand, clay, Red Clay, Shell, etc.	Thick- ness Feet	Depth Feet
(Name)	(Address)			
<u>John Butty</u>	<u>Rt 1 Summit</u>	<u>Red clay</u>	<u>12</u>	<u>12</u>
		<u>yellow sand</u>		
		<u>sand & gravel</u>		
(2) Location:	<u>1/4, 36 T 4 R 6</u>	<u>might well check</u>	<u>48</u>	<u>60</u>
<u>6</u> miles <u>west</u> of <u>McComb</u>	(distance) (direction) (Nearest Town)	<u>sand & gravel</u>	<u>12</u>	<u>72</u>
(3) Topography:	<u>hilly</u>			
(4) Purpose of Well:	<u>Domestic</u>			
	(Domestic Irrigation Municipal, Industrial, Other)			

Information upon completion of well:

- (1) Diameter 4 inches.
- (2) Total Depth 72 feet.
- (3) Water Level 50 feet below top of ground.
- (4) Cased to bottom, Size 4"
- (5) Screen: Size 4", Length 6'
- (6) Were any formations sealed against pollution?
yes, no.

If YES depth of formation _____


Why _____

Drillers Remarks: _____

Yield in gpm: 12

Size pump: P.H.P. Ref.

Type power: Electric

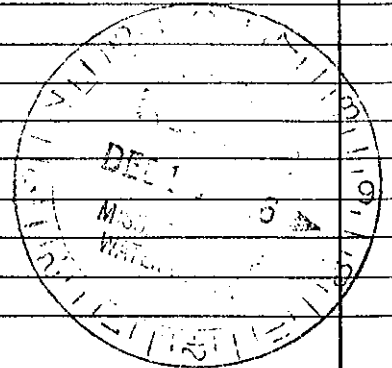

Mail this copy to Board of Water Commissioners 429 Miss. St. Jackson, Miss.