


UNITE MISSISSIPPI BOARD OF WATER COMMISSIONERS

E20

10-18-65 WATER WELL DRILLERS LOG RECORDED

Date: 10-18, 1965, Driller: J. T. Livingston For county Pike
(Name)

(1) Owner of Land: <u>Ms. Effie Clark</u> <small>(Name)</small>	Description & Color of Materials <small>Sand, Clay, Red Clay, Shell, etc.</small>	Thick- ness Feet	Depth Feet
<u>Smithdale, Miss</u> <small>(Address)</small>	<u>Sandy Clay</u>	<u>30</u>	<u>30</u>
<u>S. Mars Hill?</u>	<u>Rock & Chalk</u>	<u>20</u>	<u>50</u>
(2) Location: <u>1/4, 1/4, Sec. 20 T4R6</u>	<u>Sandy Chalk</u>	<u>40</u>	<u>90</u>
<u>12</u> miles <u>West</u> of <u>Summit</u> <small>(distance) (direction) (Nearest Town)</small>	<u>Sands</u>	<u>12</u>	<u>102</u>
(3) Topography: <u>Hilly</u> <small>(Hilly) (Flat) (Level)</small>			
(4) Purpose of Well: <u>Domestic</u> <small>(Domestic Irrigation Municipal, Industrial, Other)</small>			
Information upon completion of well:			
(1) Diameter <u>4"</u> inches.			
(2) Total Depth <u>102</u> feet.			
(3) Water Level <u>40'</u> feet below top of ground.			
(4) Cased to <u>102'</u> , Size <u>4"</u>			
(5) Screen: Size <u>4"</u> , Length <u>6'</u>			
(6) Were any formations sealed against pollution?			
_____ yes, <input checked="" type="checkbox"/> no.			
If YES depth of formation _____			
Why _____			
Drillers Remarks: _____			

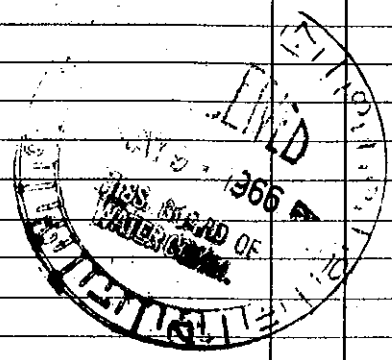

(Use Back Side)

Well No.

Mail this copy to Board of Water Commissioners 429 Miss. St. Jackson, Miss