

AMITE MISSISSIPPI BOARD OF WATER COMMISSIONERS

E22

3-15-66

WATER WELL DRILLERS LOG

Date: 3-15, 1966, Driller: J. T. Cowington & South County Ark  
(Name)

		Description & Color of Materials Sand, Clay, Red Clay, Shell, etc.	Thick- ness Feet	Depth Feet
(1) Owner of Land: <u>Mrs. Effie Clark</u> <small>(Name)</small>		<u>Sandy Clay</u>	<u>30</u>	<u>30</u>
<u>Rt. 2 Summit, Miss.</u> <small>(Address)</small>				
(2) Location: <u>1/4</u> , <u>1/4</u> , Sec. <u>17 T4R6</u> , <u>12</u> miles <u>West</u> of <u>Summit</u> , <small>(distance) (direction) (Nearest Town)</small>		<u>Sand</u>	<u>20</u>	<u>50</u>
		<u>Sand + Rock</u>	<u>25</u>	<u>75</u>
		<u>Sand Rock</u>	<u>1</u>	<u>76</u>
		<u>Sand + Rock</u>	<u>7</u>	<u>83</u>
(3) Topography: <u>Hilly</u> <small>(Hilly) (Flat) (Level)</small>				
(4) Purpose of Well: <u>Domestic</u> <small>(Domestic Irrigation Municipal, Industrial, Other)</small>				


Information upon completion of well:

- (1) Diameter 4" inches.
- (2) Total Depth 83' feet.
- (3) Water Level 60' feet below top of ground.
- (4) Cased to 83', Size 4"
- (5) Screen: Size 4", Length 6'
- (6) Were any formations sealed against pollution?  
 \_\_\_\_\_ yes,  no.

If YES depth of formation \_\_\_\_\_

Why \_\_\_\_\_

Drillers Remarks: \_\_\_\_\_

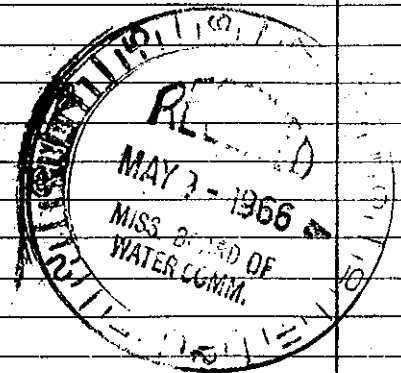

(Use Back Side)

Well No.

Mail this copy to Board of Water Commissioners 429 Miss. St. Jackson, Miss