

Amite  
E 64  
5/7/75

Coded

MISSISSIPPI  
BOARD OF WATER COMMISSIONERS  
416 North State Street  
Jackson, Mississippi 39201

CODE  
CODED

WATER WELL DRILLERS LOG

May 7 1975  
day well completed

25 Chestnut House  
firm name

Amite  
county well located

LANDOWNER:  
Mark Hill Church  
Rt. Smith Dale  
(mailing address)

| description of formations encountered | from | to |
|---------------------------------------|------|----|
| Red sandy clay                        | 0    | 24 |
| blue sand                             | 24   | 46 |
| sand & gravel                         | 46   | 58 |
| pink chalk                            | 58   | 70 |
| sand & gravel                         | 70   | 92 |

WELL LOCATION:  
SEC. 19 T. 4 N. R. 6 E. 14 H  
in miles (distance) direction (direction) nearest town (nearest town)  
in Mars Hill


WELL PURPOSE: Church  
(home, irrigation, municipal, industrial)

- WELL COMPLETION DATA:
- (1) diameter (inches) 4"
  - (2) total depth (feet) 92
  - (3) static water level (feet) 45 below top of ground.
  - (4) casing plastic cotton (material) (depth)
  - (5) screen 6" (length) 96" (depth to top)
  - (6) pump 1/2 HP (HP) 10 (yield gpm)
  - (7) electric log no (yes or no)

Coded

(8) how well bottom plugged  
wooden plug

DRILLERS REMARKS:  
present well  
short bed

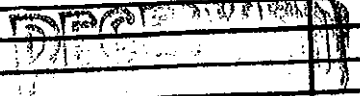

JUN 3 1975