

AMITE MISSISSIPPI BOARD OF WATER COMMISSIONERS

F22

LODED

WATER WELL DRILLERS LOG

F 300

10-11-60

Date: 10-11, 1960, Driller: Chester Reeves County Amite

| | | Description & Color of Materials Sand, Clay, Red Clay, Shell, etc. | Thick- ness Feet | Depth Feet |
|---|--|---|------------------------|---------------|
| (1) Owner of Land: <u>Wilson Cassells</u> (Name) | | <u>Red Clay</u> | <u>22</u> | <u>22</u> |
| <u>RFD, Gloster, Miss</u> (Address) | | <u>Red sand</u> | <u>53</u> | <u>75</u> |
| | | <u>small gravel</u> | <u>21</u> | <u>96</u> |
| (2) Location: <u>1/4</u> , <u>1/4</u> , Sec. <u>14</u> T <u>3</u> R <u>2</u> | | | | |
| <u>5</u> miles <u>N.E</u> of <u>Gloster</u> (distance) (direction) (Nearest Town) | | | | |
| (3) Topography: <u>Hilly</u> (Hilly) (Flat) (Level) | | | | |
| (4) Purpose of Well: <u>Domestic</u> (Domestic Irrigation Municipal, Industrial, Other) | | | | |


Information upon completion of well:

- (1) Diameter 2 inches.
- (2) Total Depth 96 feet.
- (3) Water Level 76 feet below top of ground.
- (4) Cased to Bottom, Size 2'
- (5) Screen: Size 1 1/4", Length 6'
- (6) Were any formations sealed against pollution?
 yes, no.

If YES depth of formation _____

Why _____

Drillers Remarks: _____

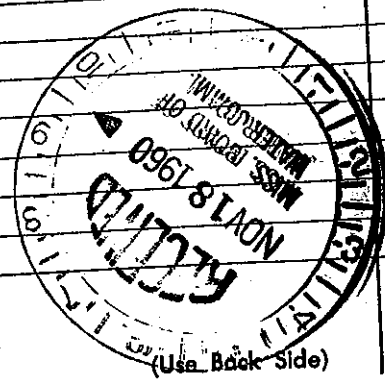

(Use Back Side)

File this copy to Board of Water Commissioners 429 Miss. St. Jackson, Mi.

Well No.