


AMITE MISSISSIPPI BOARD OF WATER COMMISSIONERS
F 23
4-30-66 **WATER WELL DRILLERS LOG**

Date: April 30, 1966, Driller: J. T. Covington County: Polk
 (Name)

		Description & Color of Materials Sand, Clay, Red Clay, Shell, etc.	Thick- ness Feet	Depth Feet
(1) Owner of Land: <u>E. J. Fournier</u> (Name)		<u>Sandy Clay</u>	<u>20</u>	<u>20</u>
<u>Ubaton, Miss.</u> (Address)				
(2) Location: $\frac{1}{4}$, $\frac{1}{4}$, Sec. <u>3</u> T <u>3</u> R <u>2</u>		<u>Sand</u>	<u>40</u>	<u>60</u>
<u>4</u> miles <u>NW</u> of <u>Ubaton</u>		<u>Gravel</u>	<u>15</u>	<u>75</u>
(distance) (direction) (Nearest Town)		<u>Chalk</u>	<u>10</u>	<u>85</u>
(3) Topography: <u>Hilly</u>		<u>Sand</u>	<u>14</u>	<u>99</u>
(Hilly) (Flat) (Level)				
(4) Purpose of Well: <u>Domestic</u>				
(Domestic Irrigation Municipal, Industrial, Other)				
Information upon completion of well:				
(1) Diameter <u>4"</u> inches.				
(2) Total Depth <u>99'</u> feet.				
(3) Water Level <u>70'</u> feet below top of ground.				
(4) Cased to <u>99'</u> , Size <u>4"</u>				
(5) Screen: Size <u>4"</u> , Length <u>6'</u>				
(6) Were any formations sealed against pollution? <input type="checkbox"/> yes, <input checked="" type="checkbox"/> no.				
If YES depth of formation _____				
Why _____				
Drillers Remarks: _____				

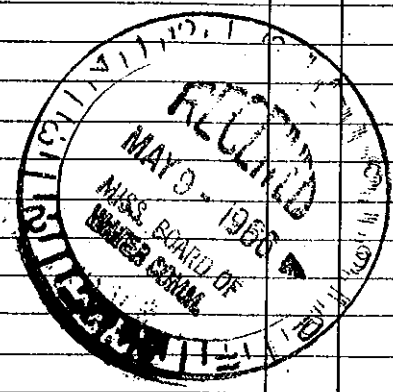

Well No.

(Use Back Side)

Mail this copy to Board of Water Commissioners 429 Miss. St. Jackson, Miss