

Amite  
F-24  
8-66

MISSISSIPPI BOARD OF WATER COMMISSIONERS

CODED

WATER WELL DRILLERS LOG

Date: Aug 10, 1966 Driller: Reverwell Pump & Co County: Amite  
(When well drilled) (Name) (Where well is located)

(1) Owner of Land	Description & Color of Materials Sand, Clay, Red Clay, Shell, etc	Thick- ness Feet	Depth Feet
<u>Clarence Haynes</u> <small>(Name)</small>	<u>Red clay &amp; gravel</u>	<u>20</u>	<u>20</u>
<u>R.F.D. Gaster</u> <small>(Address)</small>	<u>Sand (to gravel)</u>	<u>15</u>	<u>35</u>
(2) Location: <u>1/4, 1/4, Sec. 9 T3R2</u>	<u>White sand blue</u>		
<u>3</u> miles <u>south</u> of <u>Gaster</u>	<u>Clay</u>	<u>55</u>	<u>90</u>
<small>(distance) (direction) (town)</small>	<u>fine sand</u>	<u>10</u>	<u>100</u>
(3) Topography: <u>Hilly</u>	<u>Coarse sand</u>	<u>13</u>	<u>113</u>
<small>(Hilly) (Flat) (Lowland)</small>			
(4) Purpose of Well: <u>Domestic</u>			
<small>Domestic Irrigation Municipal, Industrial, Other</small>			

Information upon completion of well:

- (1) Diameter 4 inches.
- (2) Total Depth 113 feet.
- (3) Water Level 95 feet below top of ground.
- (4) Cased to Bottom, Size 4"
- (5) Screen: Size 4", Length 6'
- (6) Were any formations sealed against pollution?  
 yes,  no.

If YES depth of formation \_\_\_\_\_


Why \_\_\_\_\_

Drillers Remarks: \_\_\_\_\_

Yield in gpm: 15

Size pump: 3/4 H.P. Sub

Type power: Electric

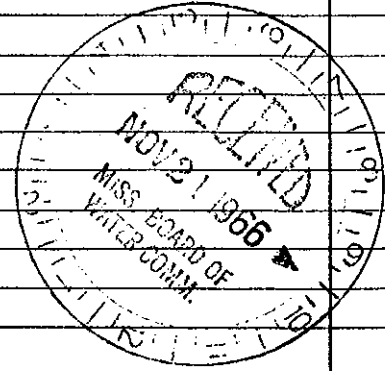

Mail this copy to Board of Water Commissioners 429 Miss. St. Jackson, Miss.