

AMITE MISSISSIPPI BOARD OF WATER COMMISSIONERS

F30

9-17-64

WATER WELL DRILLERS LOG

CODED

Date: 9-17, 1964, Driller: Chester Reeves County Amite
(Name)

(1) Owner of Land (Name) (Address)	Description & Color of Materials (Sand, Clay, Red Clay, Shell, etc.)	Thick- ness Feet	Depth Feet
Abner Perkins Glaston	Red clay	25	25
	yellow sand & gravel	45	70
	limestone	30	100
(2) Location: 1/4, 1/4, Sec 34 T3R2 3 miles east of Glaston (distance) (direction) (Nearest Town)			
(3) Topography: Hilly (Hilly) (Flat) (Level)			
(4) Purpose of Well: Domestic (Domestic Irrigation, Municipal, Industrial, Other)			

Information upon completion of well:

(1) Diameter 4 inches.

(2) Total Depth 100 feet.

(3) Water Level 71 feet below top of ground.

(4) Cased to Bottom Size 4"

(5) Screen: Size 4", Length 7'

(6) Were any formations sealed against pollution?
yes, no.


If YES depth of formation _____

Why _____

Drillers Remarks: new location
No previous well

(1) Owner of Land (Name) (Address)	Description & Color of Materials (Sand, Clay, Red Clay, Shell, etc.)	Thick- ness Feet	Depth Feet
Abner Perkins Glaston	Red clay	25	25
	yellow sand & gravel	45	70
	limestone	30	100
(2) Location: 1/4, 1/4, Sec 34 T3R2 3 miles east of Glaston (distance) (direction) (Nearest Town)			
(3) Topography: Hilly (Hilly) (Flat) (Level)			
(4) Purpose of Well: Domestic (Domestic Irrigation, Municipal, Industrial, Other)			

Location descriptions don't agree. DRN

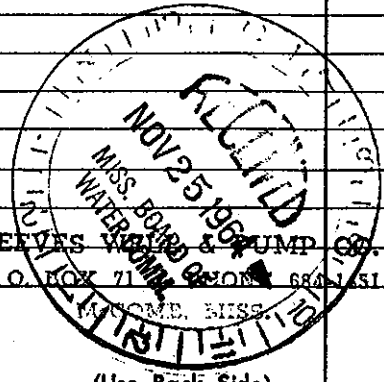

(Use Back Side)

Well No.

Mail this copy to Board of Water Commissioners 429 Miss. St. Jackson, Miss