

County: Amite
 Permit #: R60-407676
 Driller: Chris Bissard
 Date drilling completed: 3/17/16

State Well Report
Part 1 - Driller's Log
 Mississippi Department of Environmental Quality
 Office of Land and Water Resources
 P.O. Box 2309
 Jackson, MS 39225
 (601)961- 5210
 (601)961- 5228 (fax)

For Office Use Only:
 Aquifer: _____
 Well #: F64
 L. S. Elevation: _____
 E-log #: _____

State Law requires that this report be prepared by the license holder responsible for the work and filed with the Department at the above address within 30 days of completion of drilling of the well or borehole.

<p>Information on Well Owner <i>(Landowner if borehole is not for a water well)</i> Owner Name <u>Amite Bio Energy</u> Mailing Address: <u>Georgia Pacific Road 2</u> <u>Glauk MS 39638</u> City State Zip Code Telephone No. () _____</p>	<p>Well or Borehole Location Latitude: <u>31° 10' 59.6"</u> Longitude: <u>91° 02' 8.5"</u> Method of Lat/Long (circle one): Conventional Survey, USGS quad <u>Hand-held GPS</u>, Survey-grade GPS <u>SE</u> ¼ <u>NW</u> ¼ Sec <u>38</u> Twn <u>3N</u> Rng <u>2E</u> Distance Direction Nearest Town <u>1.28</u> Miles <u>SW</u> of <u>Glauk, MS</u></p>
--	--

Well / Borehole Data

Date drilling started: 3/17/16 Date drilling completed: 3/17/16 Hole depth: 30' Hole diameter: 4"

Location of the source of any surface water used for drilling: City Water Supply
 Method of dosing and volume of Chlorine used in drilling and development: _____

Logs run (circle all applicable): No log run Electric Gamma Ray Density Sonic Neutron Other: _____
 Name of organization running log(s): _____

Purpose of borehole (check one): Water Well Geotechnical Geological Investigation Ground Source Heat Pump _____
 Seismic Survey _____ Other (describe) _____

If drilling is not related to water well construction, skip the remainder of this block

Purpose of Well (check one): Home _____ Industrial _____ Public Supply _____ Irrigation _____ Fish Culture _____ Other: _____

If a flowing well, method of flow regulation: Valve _____ Other (describe) _____

Static Water Level: _____ feet above or below (circle one) land surface Date measured: _____

Method of Measurement (circle one) steel tape electric tape air line other: _____

Well depth: _____ Well grouted to a depth of _____ feet Type of grout (circle one): Neat Cement Bentonite Mix

Casing length: _____ feet Casing diameter: _____ inches Type of casing: _____

Screen length: _____ feet Screen diameter: _____ inches Type of screen: _____

Screen slot size: _____ inches Setting depth: From _____ feet to _____ feet

Type of completion (circle all applicable): Gravel packed Underreamed Telescoped Open hole Natural Development
 Other (describe): _____

Top of lap pipe or reduction in casing: _____ feet. *If telescoped or more than one screen, describe on next page*

Form: OLWR-SWR-1A (04/08)


MAR 31 2016

F 64

The sketch below only required for water wells

If well telescopes, show depths on sketch.

Ground Level \rightarrow

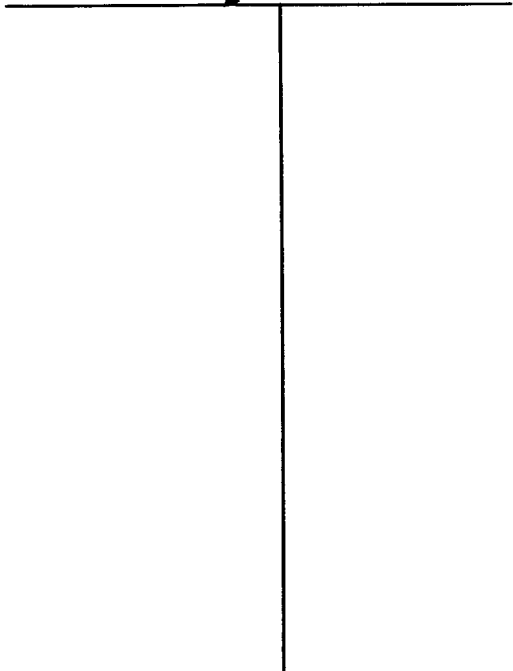

Description of formations encountered must be provided for all wells and boreholes, unless specifically exempted by regulations

Description of Formations Encountered	From (depth) Ground Level	To (depth)

If more than one screen, show location of each on sketch

Sketch the property layout and include the following: 1) the well location; 2) any permanent structures on the property that may aid in locating the well; 3) any roads, power lines, or other items that may aid in locating the property and the well; 4) a north arrow.


Landowner Name: _____

Form: OLWR-SWR-1A (04/08)

I certify that the well/borehole was drilled, constructed, and completed in accordance with all applicable requirements of the Mississippi Department of Environmental Quality and the Mississippi Department of Health regulations, if applicable, and state laws.

Chris Blissard, RG0-407676, 3/25/16

Print Name of Responsible Licensee and License No. Date

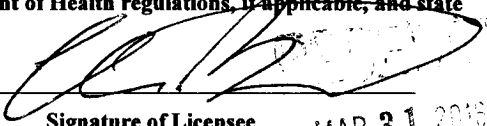

Signature of Licensee

MAR 31 2016

00000

SOIL BORING LOG

FLY

PROJECT: Geotechnical Investigation
 Amite Bioenergy Existing Crane Rail
 Gloster, Mississippi

No. B-1
 SHEET 1 OF 1

PROJECT NO.: ST.02361.000.001.02
 DATE: 3/17/16
 DRILLER: J. Stevens
 TECHNICIAN: C. Blissard
 ENGINEER: M. Volk

CLIENT: Amite Bioenergy
 Gloster, Mississippi

Location: 31°10'59.6" -91°02'08.5"

LABORATORY DATA

Depth (ft)	Symbol	Samples	DESCRIPTION OF MATERIAL	Field Test Results	Undrained Shear Strength (ksf)	Moisture Content (%)	Unit Weight (pcf)		Plasticity Index	Cohesion / Δ Triaxial (ksf)				% Passing No. 200
							Moist	Dry		PL ——— MC% ——— LL				
										1	2	3	4	
Surface Elevation: 403 ft. +/-														
			Medium dense to dense tan and gray silty sand (SM) - with gravel to 4'	28 b/f 14-16-12		14							27.2	
5			- tan and red below 4'	18 b/f 8-9-9		10							21.1	
10			- loose to medium dense below 8'	9 b/f 4-4-5		9								
15				6 b/f 5-3-3		8							12.7	
20			Loose to medium dense tan and red sand (SP)	8 b/f 4-4-4		6								
25			- medium dense below 24'	10 b/f 4-5-5		5								
30			- with trace of gravel below 29'	12 b/f 5-2-10		10								

Terminal Depth at 30.0 ft

SOIL BORING LOG WITH ELEVATION 2361.000.001.02.GPJ GEOTECHNICAL TEMPLATE.GDT 3/29/16

MAR 31 2016

Groundwater Observations	Advancement Method	Notes
No groundwater encountered	0 - 30 ft: Machine Auger	
	Abandonment Method	
	Boring grouted upon completion	Elevation estimated from Google Earth Pro Blow counts determined from automatic hammer
SoilTech Consultants		