

MISSISSIPPI DEPARTMENT OF NATURAL RESOURCES
Bureau of Land and Water Resources

P.O. Box 10631
Jackson, Mississippi 39209
WATER WELL DRILLERS LOG

COUNTY WELL LOCATED <u>Amite</u>		PERMIT NUMBER <u>0-453</u>
WELL NUMBER <u>Tuminello #1</u>	CODED	NAME OF DRILLING FIRM <u>Morris Brothers</u>
DATE WELL COMPLETED <u>F 2016</u> <u>4/19/91</u>		<u>Trout, La 71371</u>

NAME & MAILING ADDRESS OF LANDOWNER <u>Plains Resources</u> <u>1600 Smith St.</u> <u>Cullen Center</u> <u>Houston, Texas 77002</u>			
WELL LOCATION:	SEC <u>36</u>	TOWNSHIP <u>3</u>	RANGE <u>N 2 E</u> <u>S W</u>
DISTANCE	DIRECTION	NEAREST TOWN	
Miles <u>5</u>	of <u>S</u>	<u>Gloster</u>	
OTHER LANDMARK <u>Natchez Rd.</u>			
WELL PURPOSE: Home, Irrigation, Municipal, Industrial, Fish Pond, etc. <u>Rig Supply</u>			

PUMP DATA		
PUMP TYPE (Circle One): <u>Submersible</u> Turbine, Jet, Flowing Well, Other (Describe)		
POWER TYPE (Circle One): <u>Electric</u> Tractor, Diesel, Gasoline, Butane, Other (Describe) <u>H/P 7/2</u>		
Pump Capacity (GPM)	No. of Stages	Setting Depth FT.
PUMP TEST		
Well yielded <u>60</u> GPM with a drawdown of _____ ft. after _____ hours of pumping		

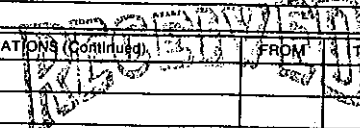
WELL DATA		
Well Depth <u>215</u>	Casing Diameter (In.) <u>4</u>	Casing Length (Ft.) <u>185</u>
Type of Casing <u>PVC</u>	Hole Depth <u>215</u>	Depth to Static Water Level <u>80</u>
TYPE OF COMPLETION: (Circle One or More): <u>Gravel Packed</u> , Underreamed, Telescoped, Natural Development, Open Hole, Other (Describe)		
Top of Lap Pipe or Reduction in Casing FEET IF TELESCOPED OR MORE THAN ONE SCREEN: USE BACK PAGE		

LOG DATA	
TYPE OF LOG RUN (Circle One): No Log Run, Electric, Gamma Ray, Density, Sonic, Neutron, Other (Describe)	
Name of Organization Running Log	

SCREEN DATA		
Diameter - Inches <u>4</u>	Length - Feet <u>30</u>	Slot Size - Inches <u>10' - .010</u> <u>20' - .025</u>
Screen Type <u>PVC</u>	Depth to Bottom - Feet <u>15</u>	

GEOLOGIC DATA (Office Use Only)			
Surface Elev.	Geologic Unit	Unit Thickness	Depth to Top
Subs. SWL	Date	Analysis	Aquifer Test
Driller's Remarks			

DESCRIPTION OF FORMATIONS ENCOUNTERED	FROM	TO	FORMATIONS (Continued)	FROM	TO
<u>Red Clay & Sand</u>	<u>0</u>	<u>20</u>			
<u>Sand Med Coarse</u>	<u>20</u>	<u>60</u>			
<u>Sand & Clay</u>	<u>60</u>	<u>80</u>			
<u>Sand & Clay</u>	<u>80</u>	<u>100</u>			
<u>Clay</u>	<u>100</u>	<u>120</u>			
<u>Clay-sand Strks</u>	<u>120</u>	<u>140</u>			
<u>Hard & Sandy Clay</u>	<u>140</u>	<u>160</u>			
<u>Sandy Clay with Sand</u>	<u>160</u>	<u>180</u>			
<u>Med Coarse Sand</u>	<u>180</u>	<u>200</u>			
<u>Clay</u>	<u>200</u>	<u>215</u>			


 JUN 24 1991
 Dept. of Environmental Quality
 Bureau of Land & Water Resources

IF MORE SPACE IS NEEDED, USE BACK