

AMITE
AGI

MISSISSIPPI BOARD OF WATER COMMISSIONERS

11-18-65

WATER WELL DRILLERS LOG

CODED

Date: 11-18, 1965, Driller: Chester Reeves County: Amite

(Name)

(1) Owner of Land: <i>L.B. Whittington</i> <i>H. G. Claster</i> (Name) (Address)	Description & Color of Materials Sand, Clay, Red Clay, Shell, etc. <i>white silty clay</i> <i>Red Chalk</i> <i>Hard granitic sand</i>	Thick- ness Feet <i>15</i> <i>25</i> <i>74</i>	Depth Feet <i>15</i> <i>40</i> <i>114</i>
(2) Location: $\frac{1}{4}$, $\frac{1}{4}$, Sec <i>5</i> <i>B.R.3.</i> <i>12</i> miles <i>N.W.</i> of <i>Claster</i> (distance) (direction) (Nearest Town)			
(3) Topography: <i>Hilly</i> (Hilly) (Flat) (Lowly)	<p>This location is about 6 miles NE of Claster.</p> <p>RN</p>		
(4) Purpose of Well: <i>Domestic</i> (Domestic Irrigation Municipal, Industrial, Other)			


Information upon completion of well:

- (1) Diameter *4* inches.
- (2) Total Depth *114* feet.
- (3) Water Level *90* feet below top of ground.
- (4) Cased to *Bottom*, Size *4"*
- (5) Screen: Size *4"*, Length *6'*
- (6) Were any formations sealed against pollution?
_____ yes, no.

If YES depth of formation _____

Why _____

Drillers Remarks: *sed well*
No good

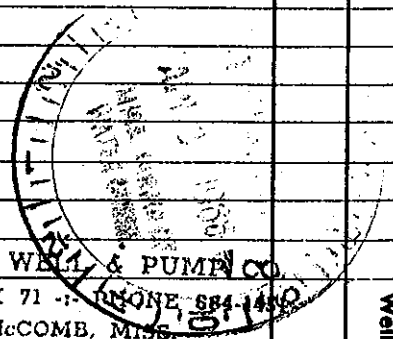

BEEVES WELL & PUMP CO.
R. Q. BOX 71 - PHONE 884-1440
McCOMB, MISS.

(Use Back Side)

Well No.

Mail this copy to Board of Water Commissioners 429 Miss. St. Jackson, Miss