

Amite
 G4
 6-67

MISSISSIPPI
 BOARD OF WATER COMMISSIONERS
 416 North State Street
 Jackson, Mississippi 39201

CODED

WATER WELL DRILLERS LOG

6-29-67 date well completed
 Filigore W.W. firm name
 Amite county well located


LANDOWNER: Dick Stevenson
Liberty Rd MISS
 (mailing address)

description of formations encountered	from	to
Hard Surface	0	5
Red Clay	5	15
Red Sand	15	45
Red Sand + gravel	45	70
Chalky sand	70	85
Whitesand + gravel	85	92
To Red M Clay		

WELL LOCATION:
 sec 3 T. 3 N. R. 3 E.
6 miles W of Liberty
 (distance) (direction) (nearest town)

WELL PURPOSE: house
 (home, irrigation, municipal, industrial)

- WELL COMPLETION DATA:
- (1) diameter (inches) 4
 - (2) total depth (feet) 92
 - (3) static water level (feet) 50 below above top of ground.
 - (4) casing plastic, 86
 (material) (depth)
4 (size) if telescope see back.
 - (5) screen 6', 86
 (length) (depth to top)
4 (size), plastic (material)
 - (6) pump 1/2 Soft, 10
 (HP) (yield gpm)
Elec (type power)
 - (7) electric log NO
 (yes or no)
- (organization running log)
- (8) how well bottom plugged plugged

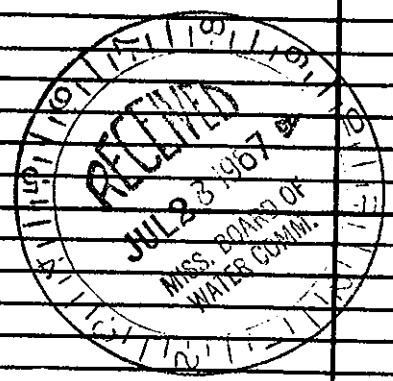

DRILLERS REMARKS: